

EAST 30ft. LOT 21 BLOCK 10 WOODLAND PARK.


JOHN B. IRVINE, SURVEYOR.

408 GLOBE BLDG.

ST. PAUL, MINN.

NOV. 27-1915.

scale. 20ft. per inch.

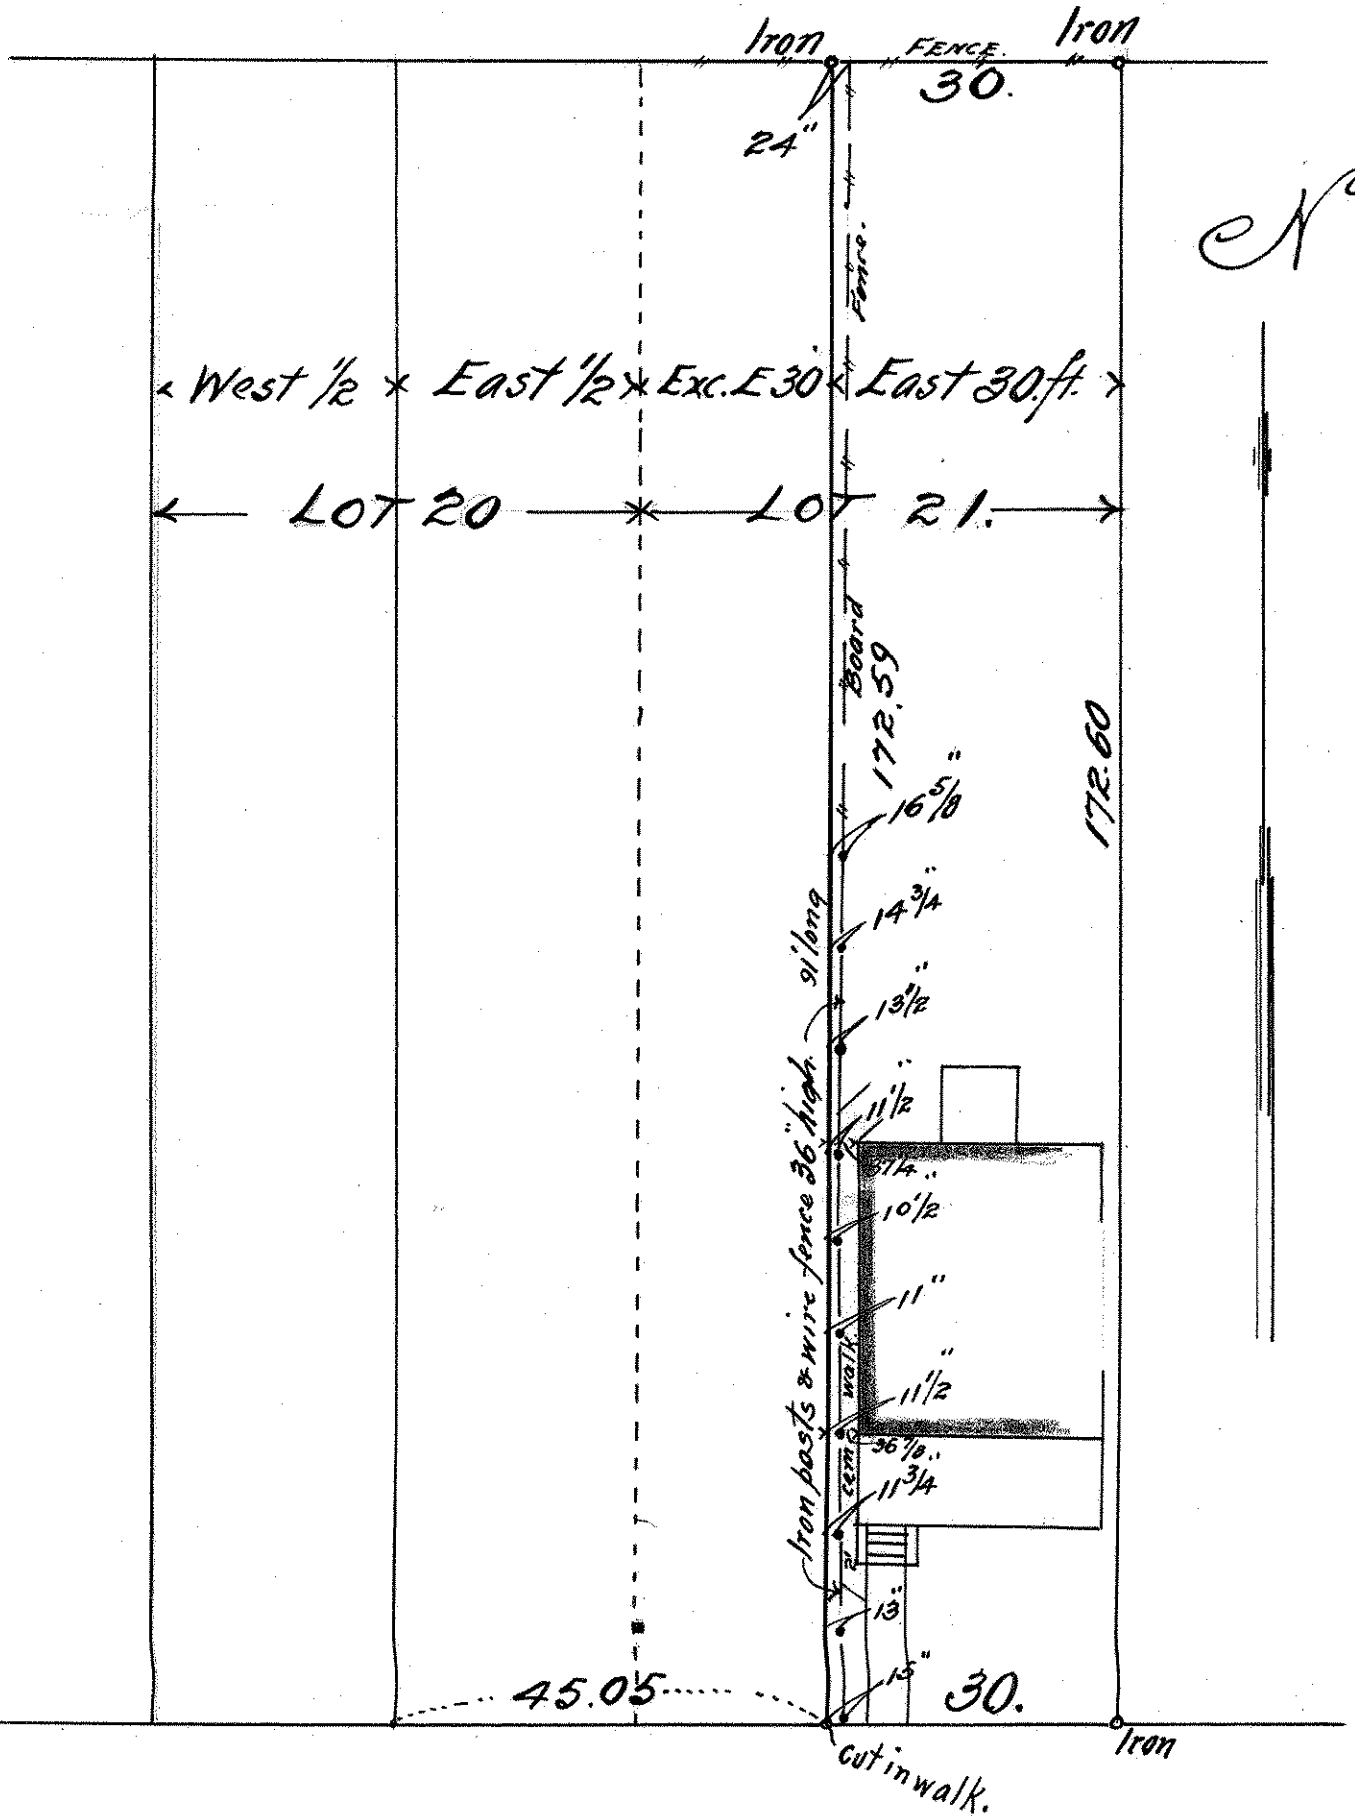

LAUREL AVE.