


LOT 21. BLOCK 14
 WOODLAND
 PARK ADD.

JOHN B. IRVINE SURVEYOR.
 408 GLOBE BLDG.
 ST. PAUL MINN.
 SEPT 19-1916
 Scale 20ft per inch.

ALLEY

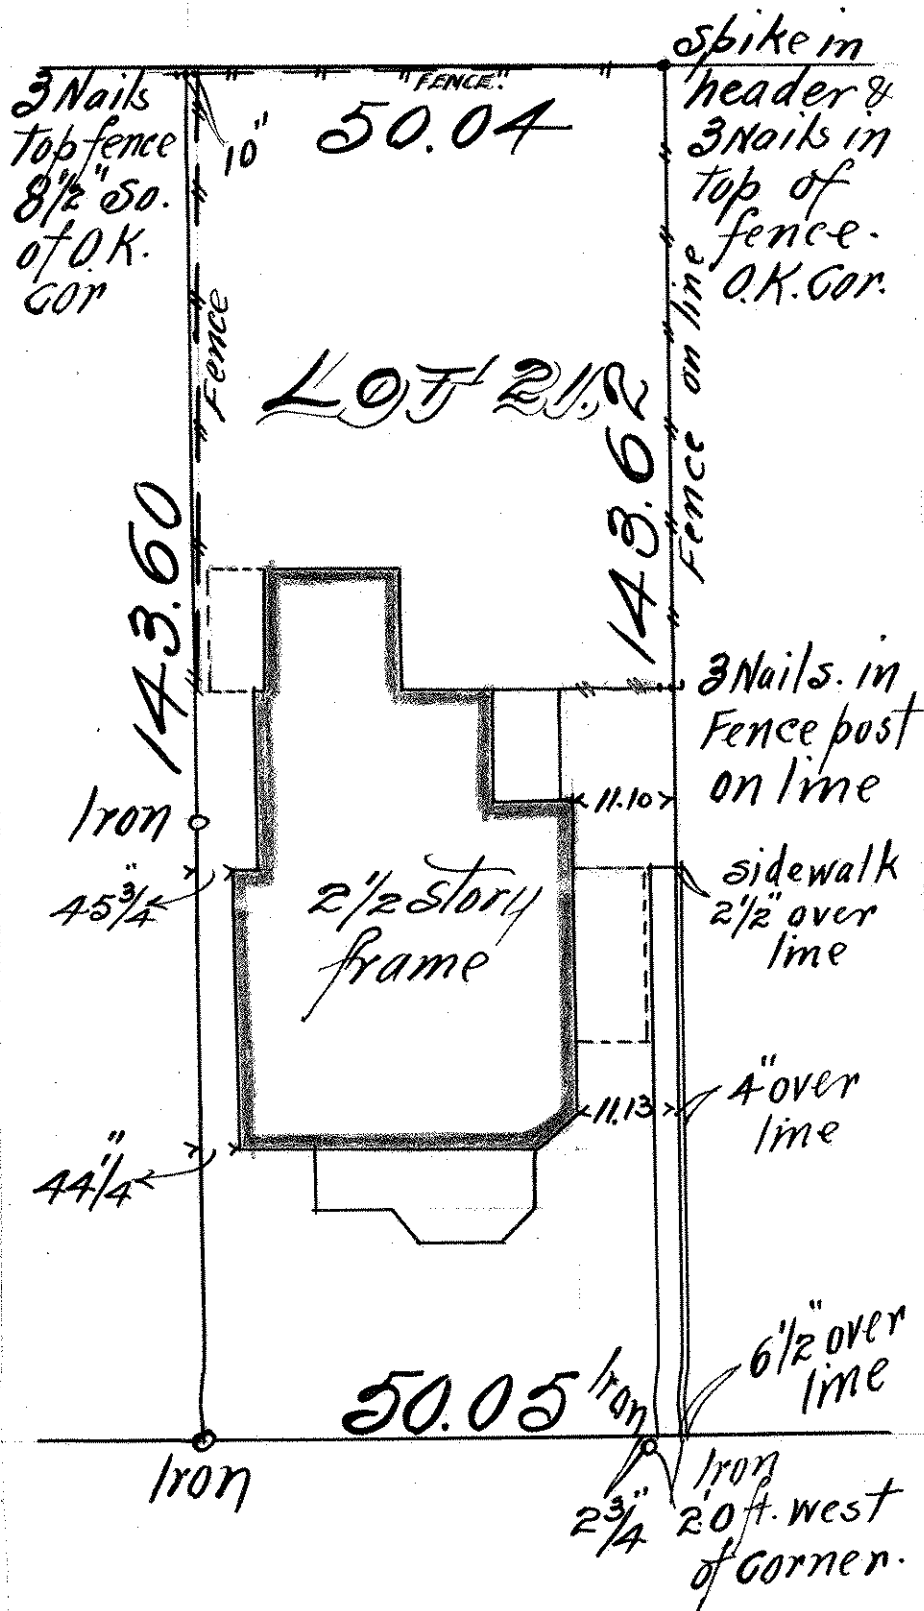

HOLLY AVE.