

LOTS 1, 2, 3 & 4 BLOCK 15

WOODLAND PARK

SCALE 20 ft per inch.


JOHN B. IRVINE, SURVEYOR

416 GLOBE BLD'G.

ST PAUL MINN.

MAY 31-07.

ASHLAND AVE.

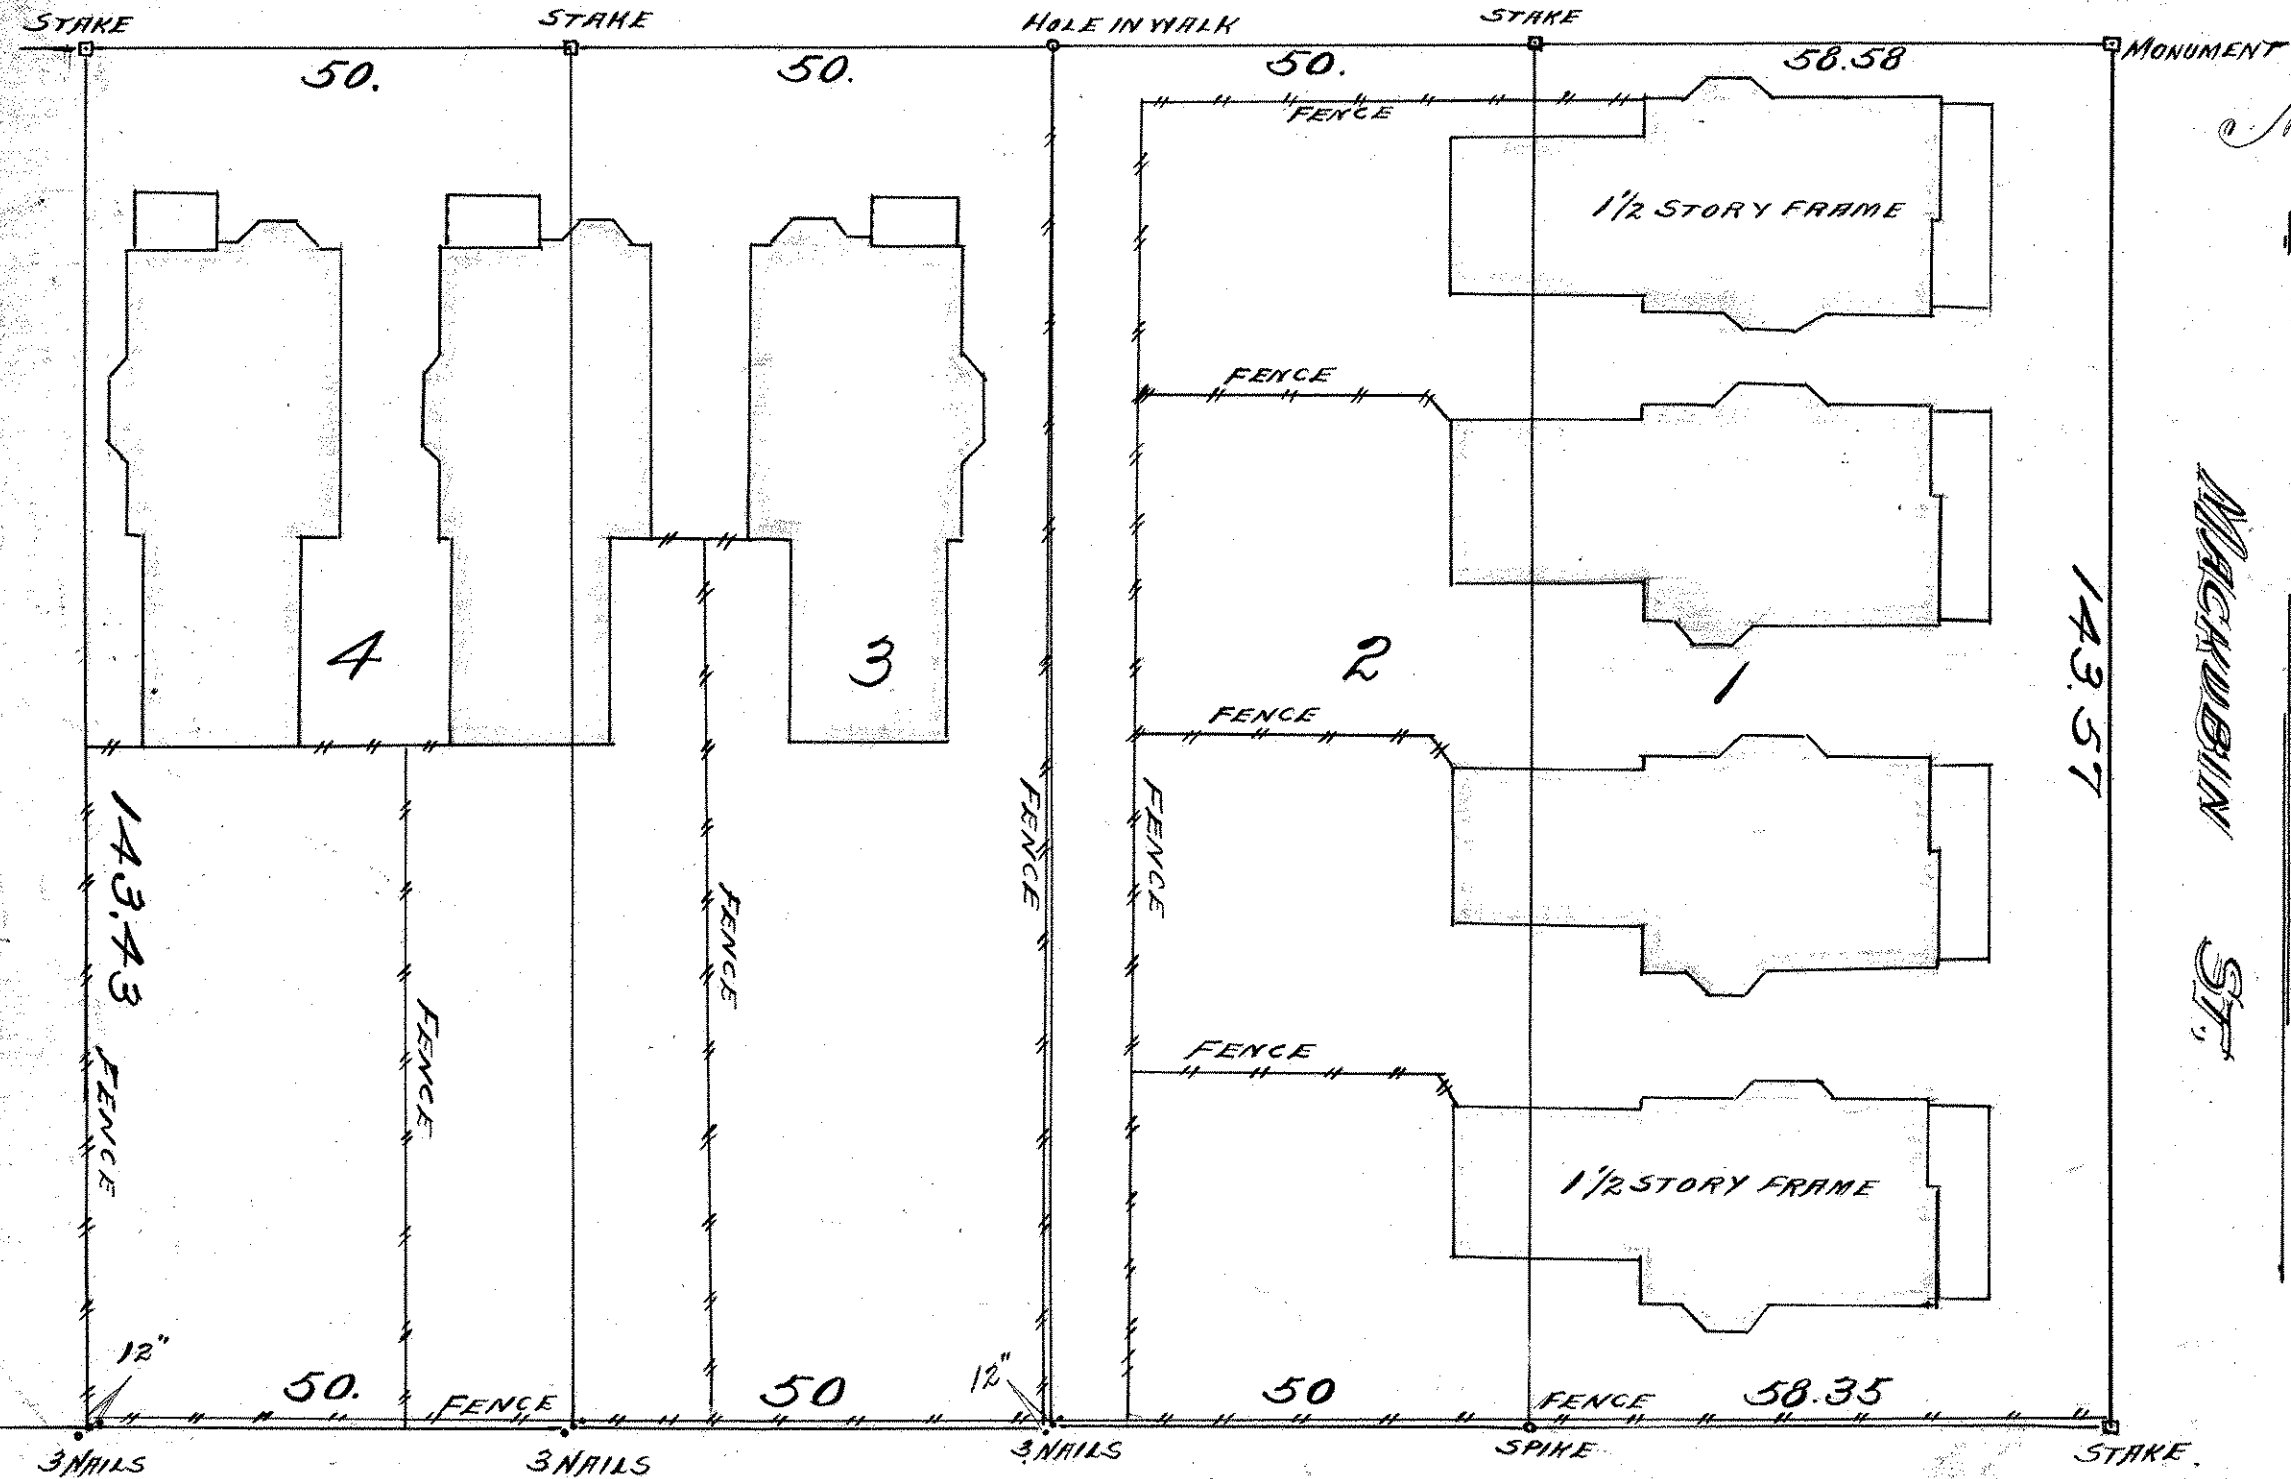

ALLEY

MACKUBIN ST