

"Note"


Figures underlined =
Elevations above 0.0 on top curb

Dotted lines A. H. B. B. =
Where lines of Lot 7 would be
placed if surplus in block
were prorated between all lots.
Surplus = strip abandoned by city

ASHLAND AVE.

LOT 7 BLOCK 16 WOODLAND PARK

JOHN B. IRVINE, SURVEYOR.
408 GLOBE BLDG.
ST. PAUL, MINN.
MARCH 5-1913
scale 20 ft per inch.

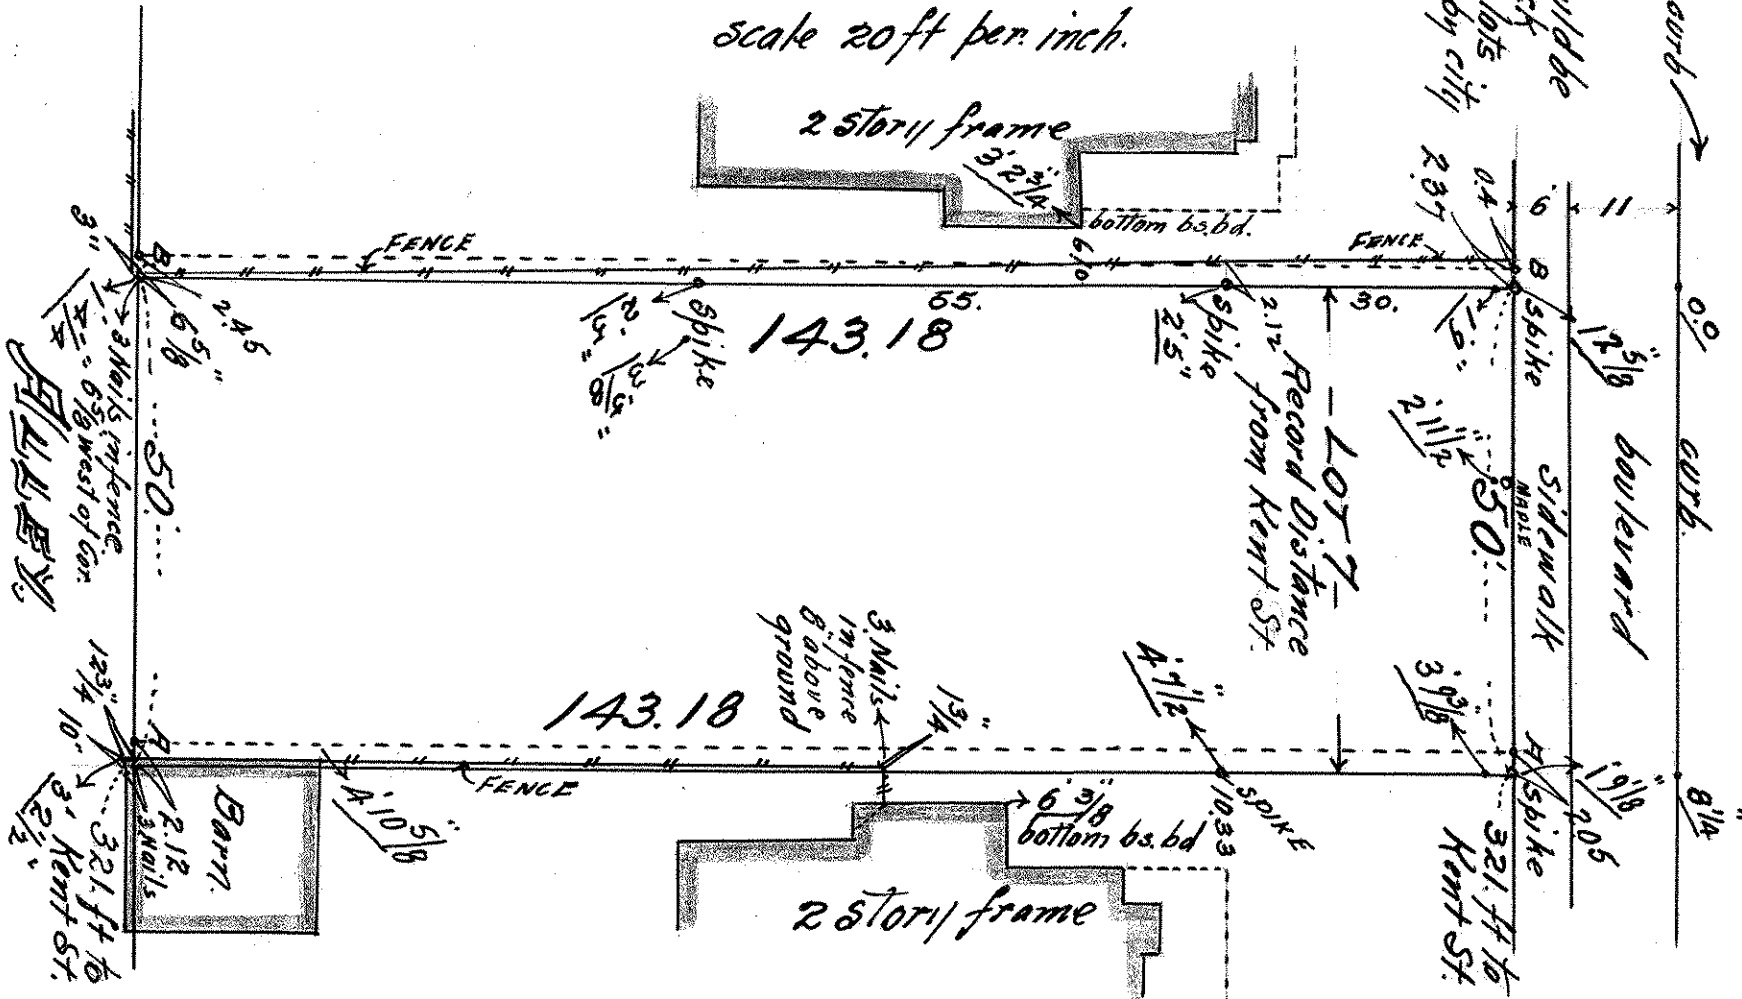

DALE ST.

strip abandoned by city

71.	12	143.19	15	71.	11	143.19	15	71.	50	592. Records	ASHLAND AVE.	595.75 Measure	71.	1	143.18	15	71.	50	592. Records	HOLLY AVE.	596.07 Measure.	71.	22.	143.18
71.	13	143.19	15	71.	10	143.19	15	71.	50	"			50.	2	143.18	15	71.	50	"			71.	21	143.18
71.	14	143.19	15	71.	9	143.19	15	71.	50	"			50.	3	143.18	15	71.	50	"			71.	20	143.18
71.	15	143.19	15	71.	8	143.19	15	71.	50	"			50.	4	143.18	15	71.	50	"			71.	19	143.18
71.	16	143.19	15	71.	7	143.19	15	71.	50	"			50.	5	143.18	15	71.	50	"			71.	18	143.18
71.	17	143.19	15	71.	6	143.19	15	71.	50	"			50.	6	143.18	15	71.	50	"			71.	17	143.18
71.	18	143.19	15	71.	5	143.19	15	71.	50	"			50.	7	143.18	15	71.	50	"			71.	16	143.18
71.	19	143.19	15	71.	4	143.19	15	71.	50	"			50.	8	143.18	15	71.	50	"			71.	15	143.18
71.	20	143.19	15	71.	3	143.19	15	71.	50	"			50.	9	143.18	15	71.	50	"			71.	14	143.18
71.	21	143.19	15	71.	2	143.19	15	71.	50	"			50.	10	143.18	15	71.	50	"			71.	13	143.18
71.	22	143.19	15	71.	1	143.19	15	71.	50	"			50.	11	143.18	15	71.	50	"			71.	12	143.18

Scale 100 ft. per inch

Monument.