

FEB 1908

LOT 10 EXCEPT SOUTH 30 FT. SUBDIVISION OF BLOCK 17 WOODLAND PARK ADD.

JOHN B. IRVINE, SURVEYOR.
S. T. PAUL MINN.
FEB. 4-08.

SCALE 20ft. per inch




HOLLY

AVE.

DALE ST.

DALE

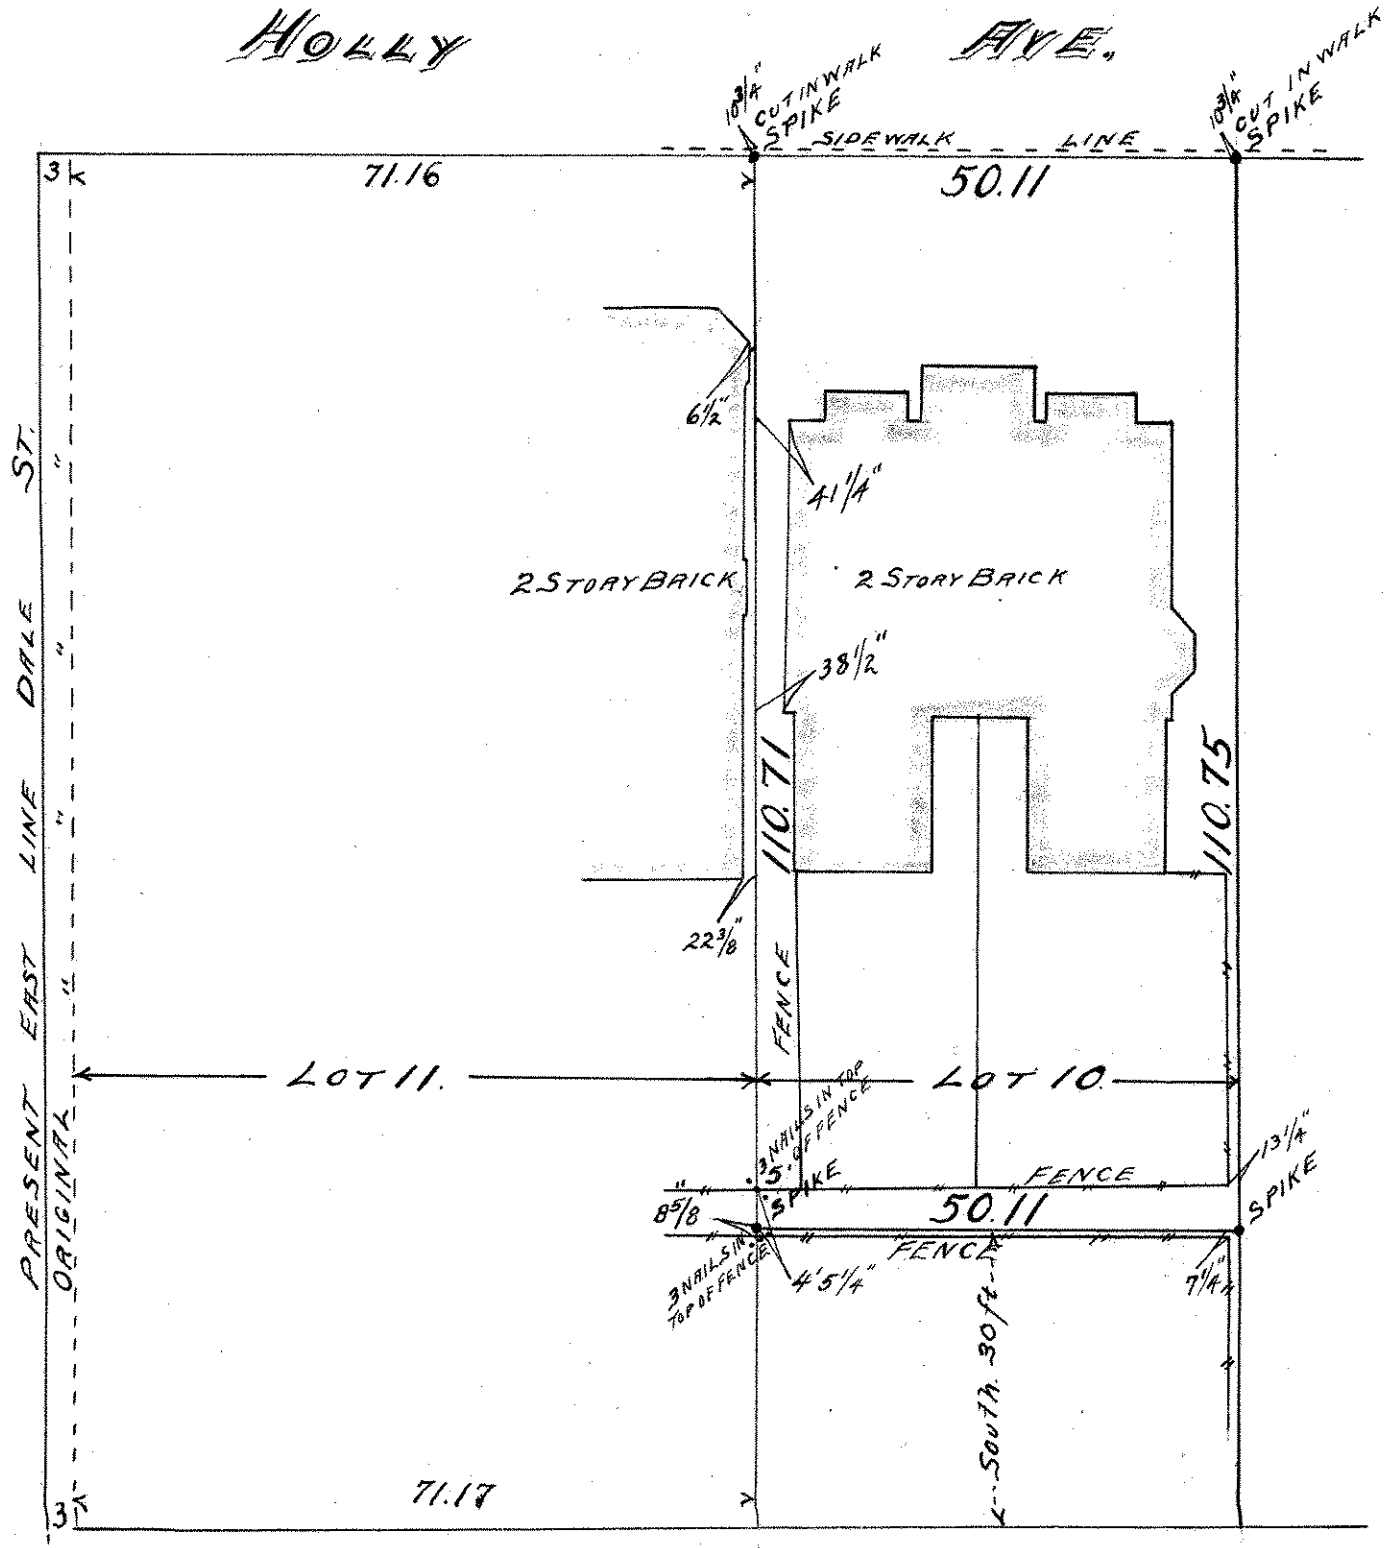

ALLEY 20'