


LOT 14
SUBDIVISION OF
BLOCK 17
WOODLAND PARK.

JOHN B. IRVINE, SURVEYOR,
408 GLOBE BLDG.
ST PAUL, MINN.
FEB. 27-1911.

SCALE 40 ft. per inch.

N

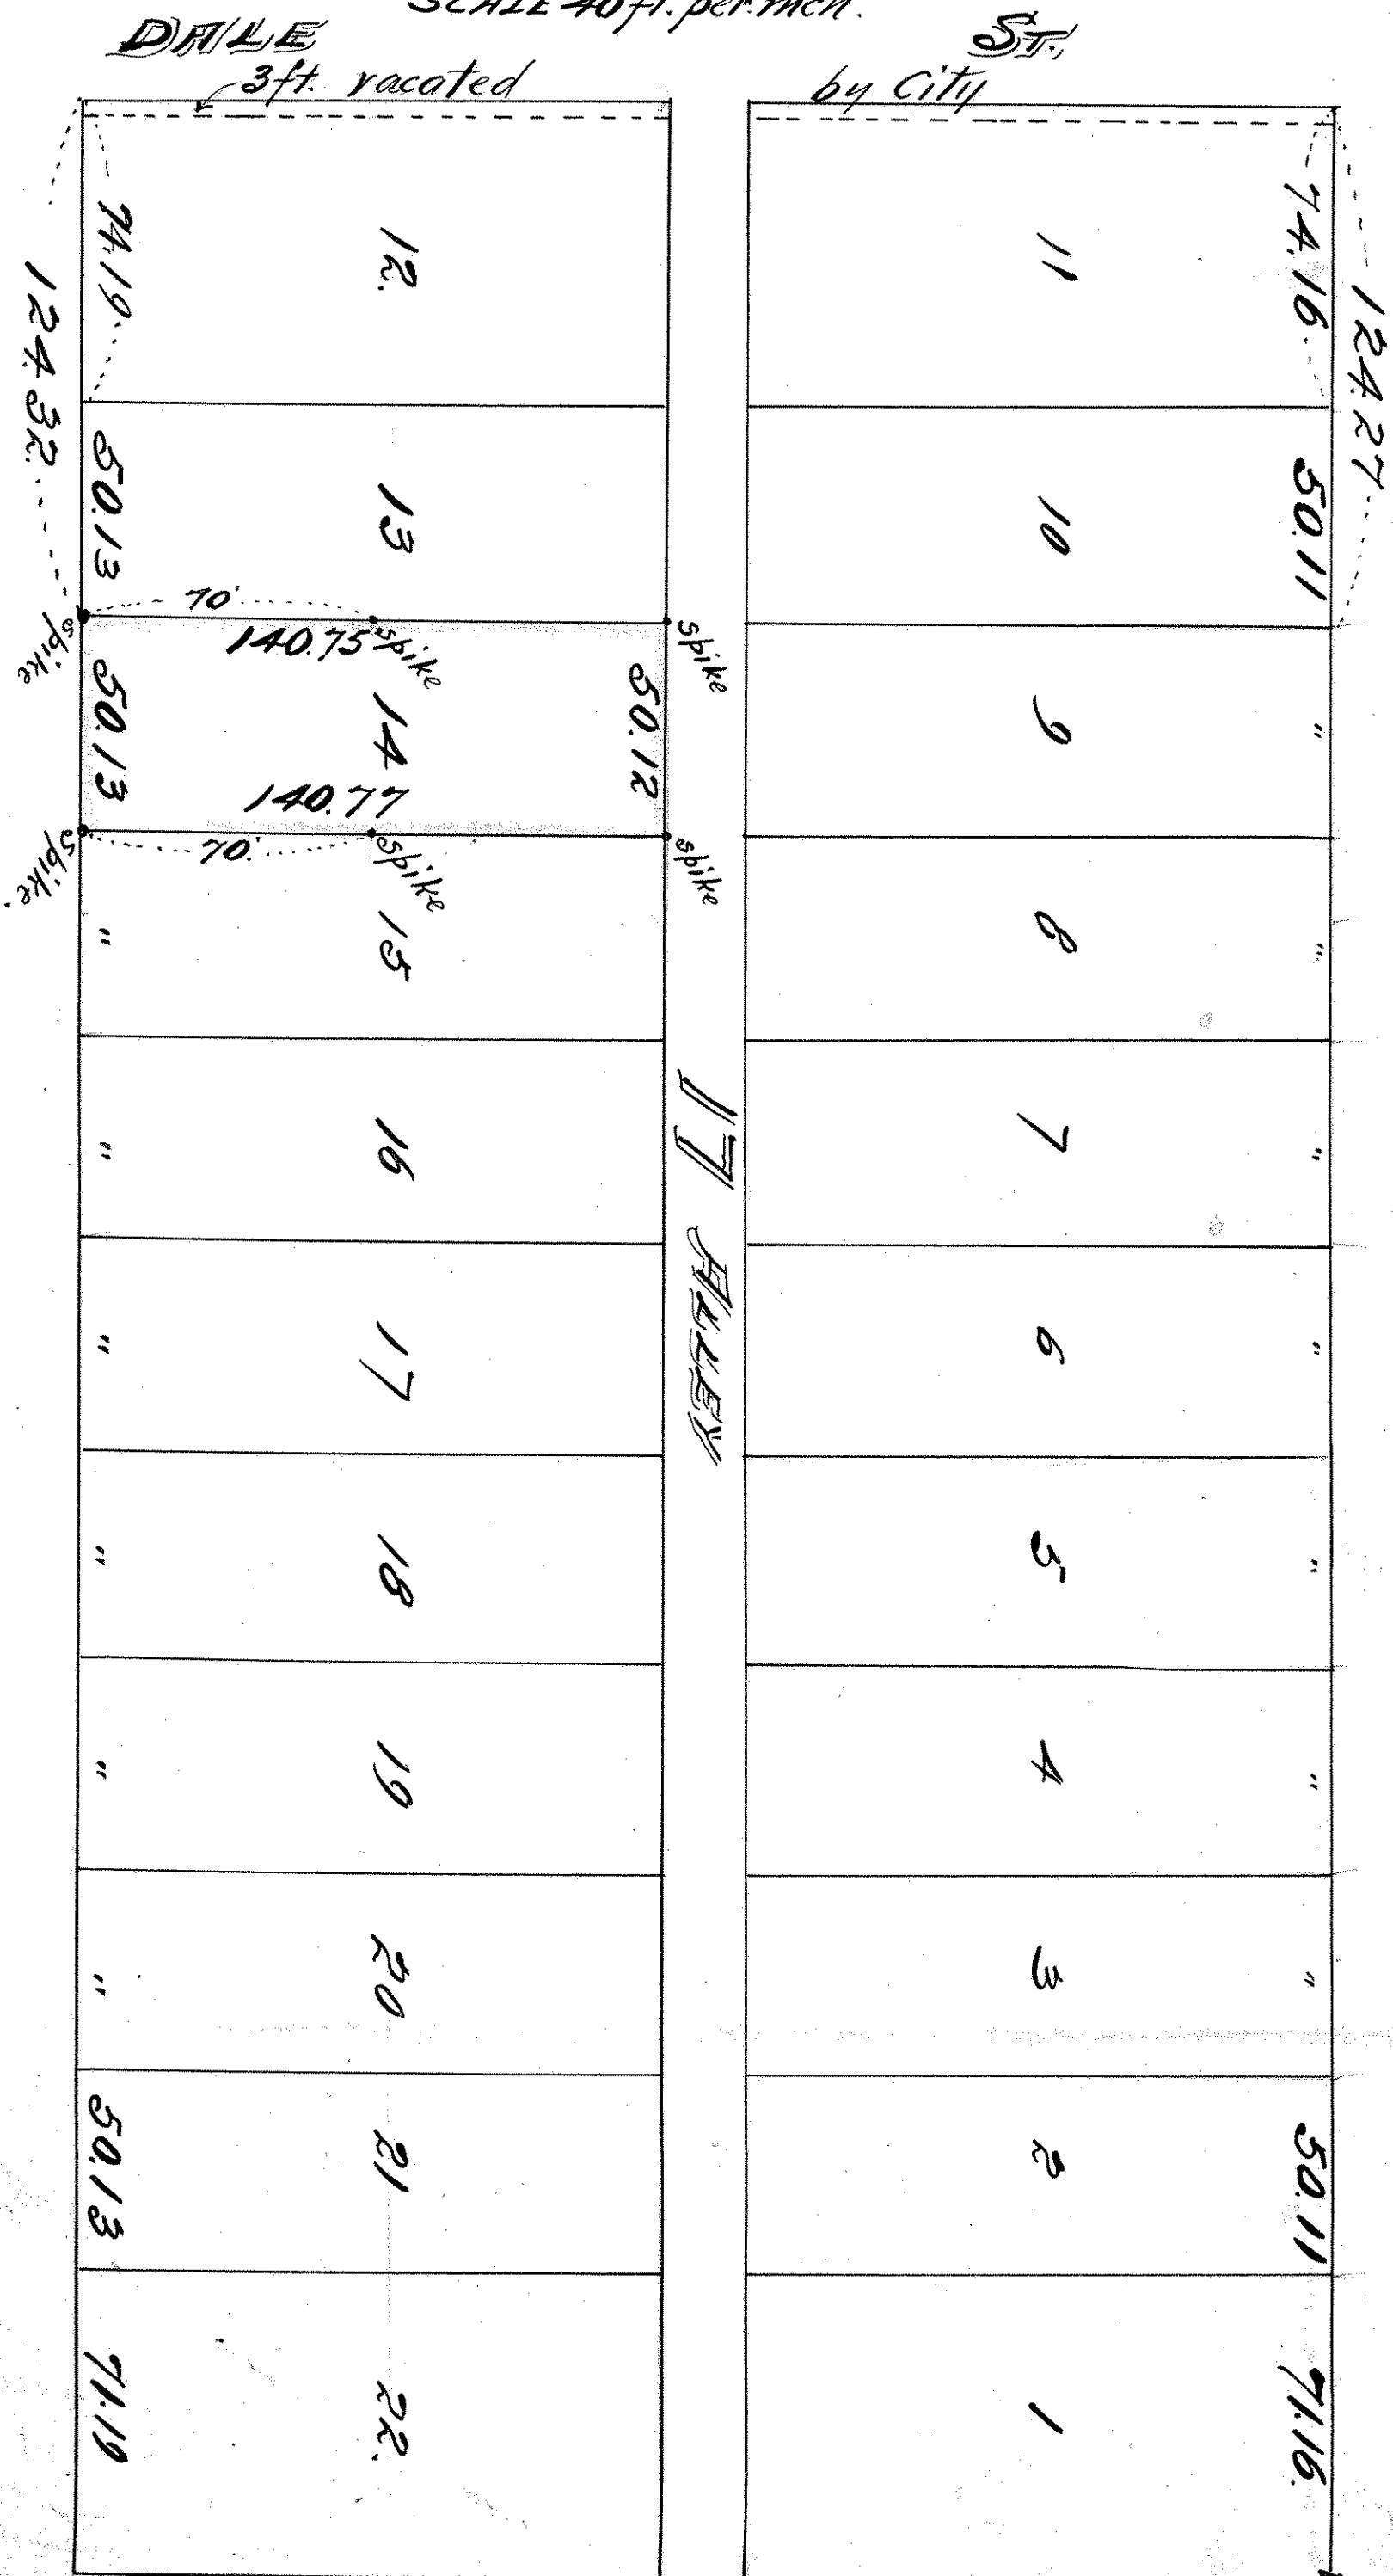

PORTLAND

AVE.

HOLLY

AVE.

KENT

ST.

Mont.