LOT 7 EXCEPT EAST 5 ft.
SUBDIVISION OF PART OF
BLOCK 20
WOODLAND PARK ADD

JOHN B. IRVINE, SURVEYOR.
408 GLOBE BLDG.
ST. PAUL, MINN
APRIL 16-1914
Scale 20 ft. per inch.

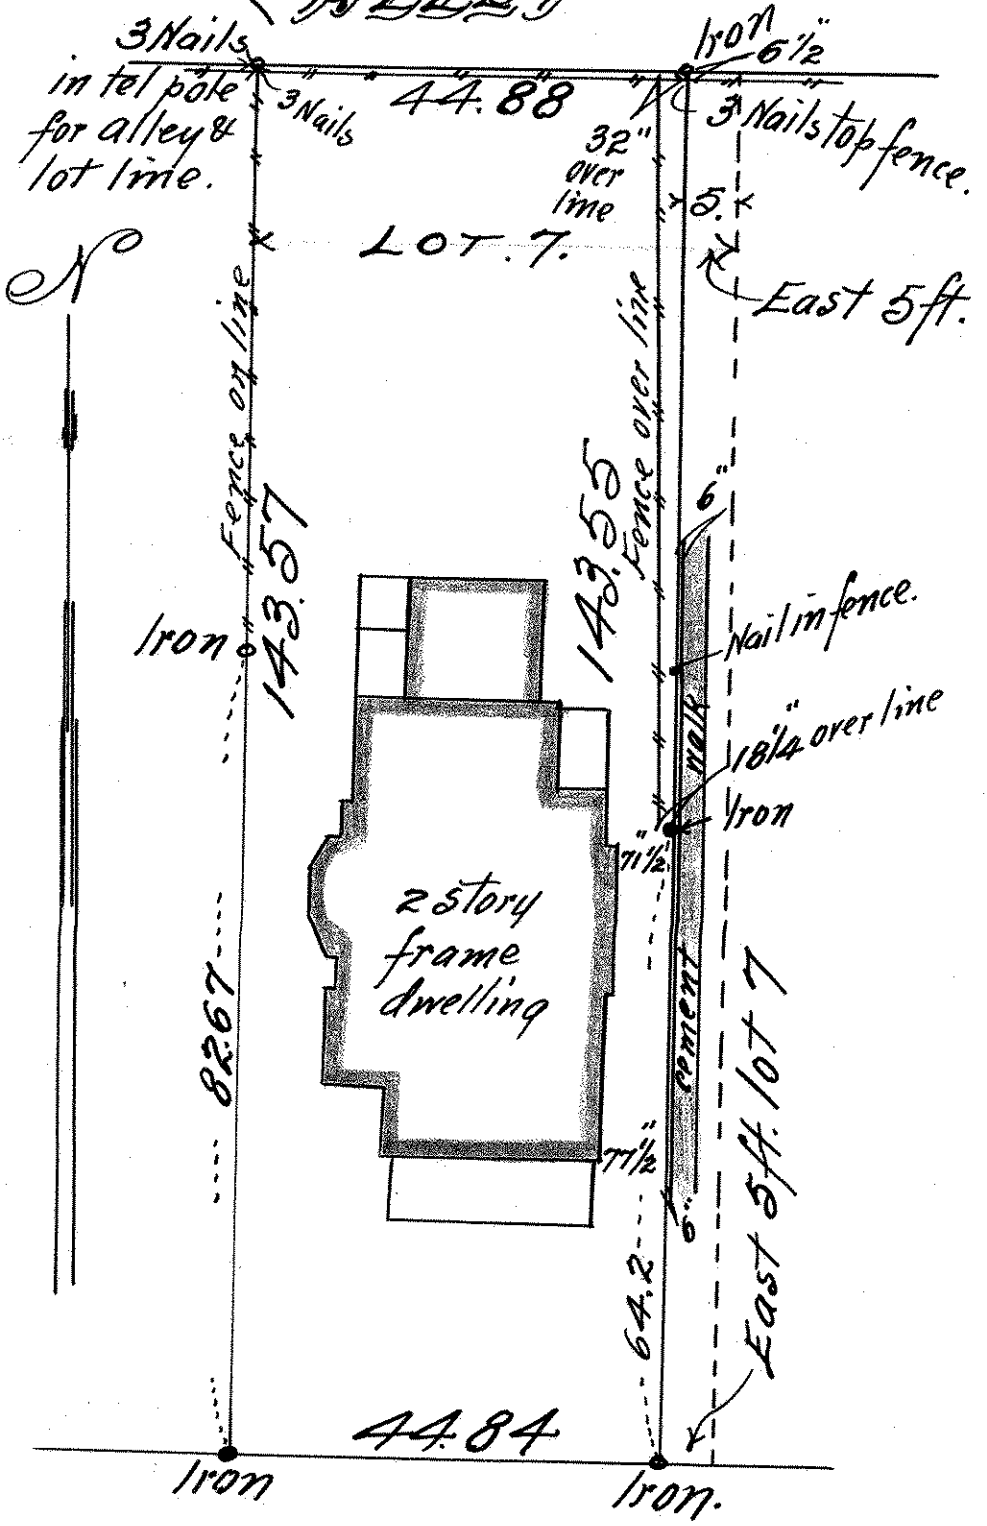

PORTLAND AVE.