


LOT 19 BLOCK 1
WOODLAND PARK
scale 20 ft per inch
SUR. July 21st 1902

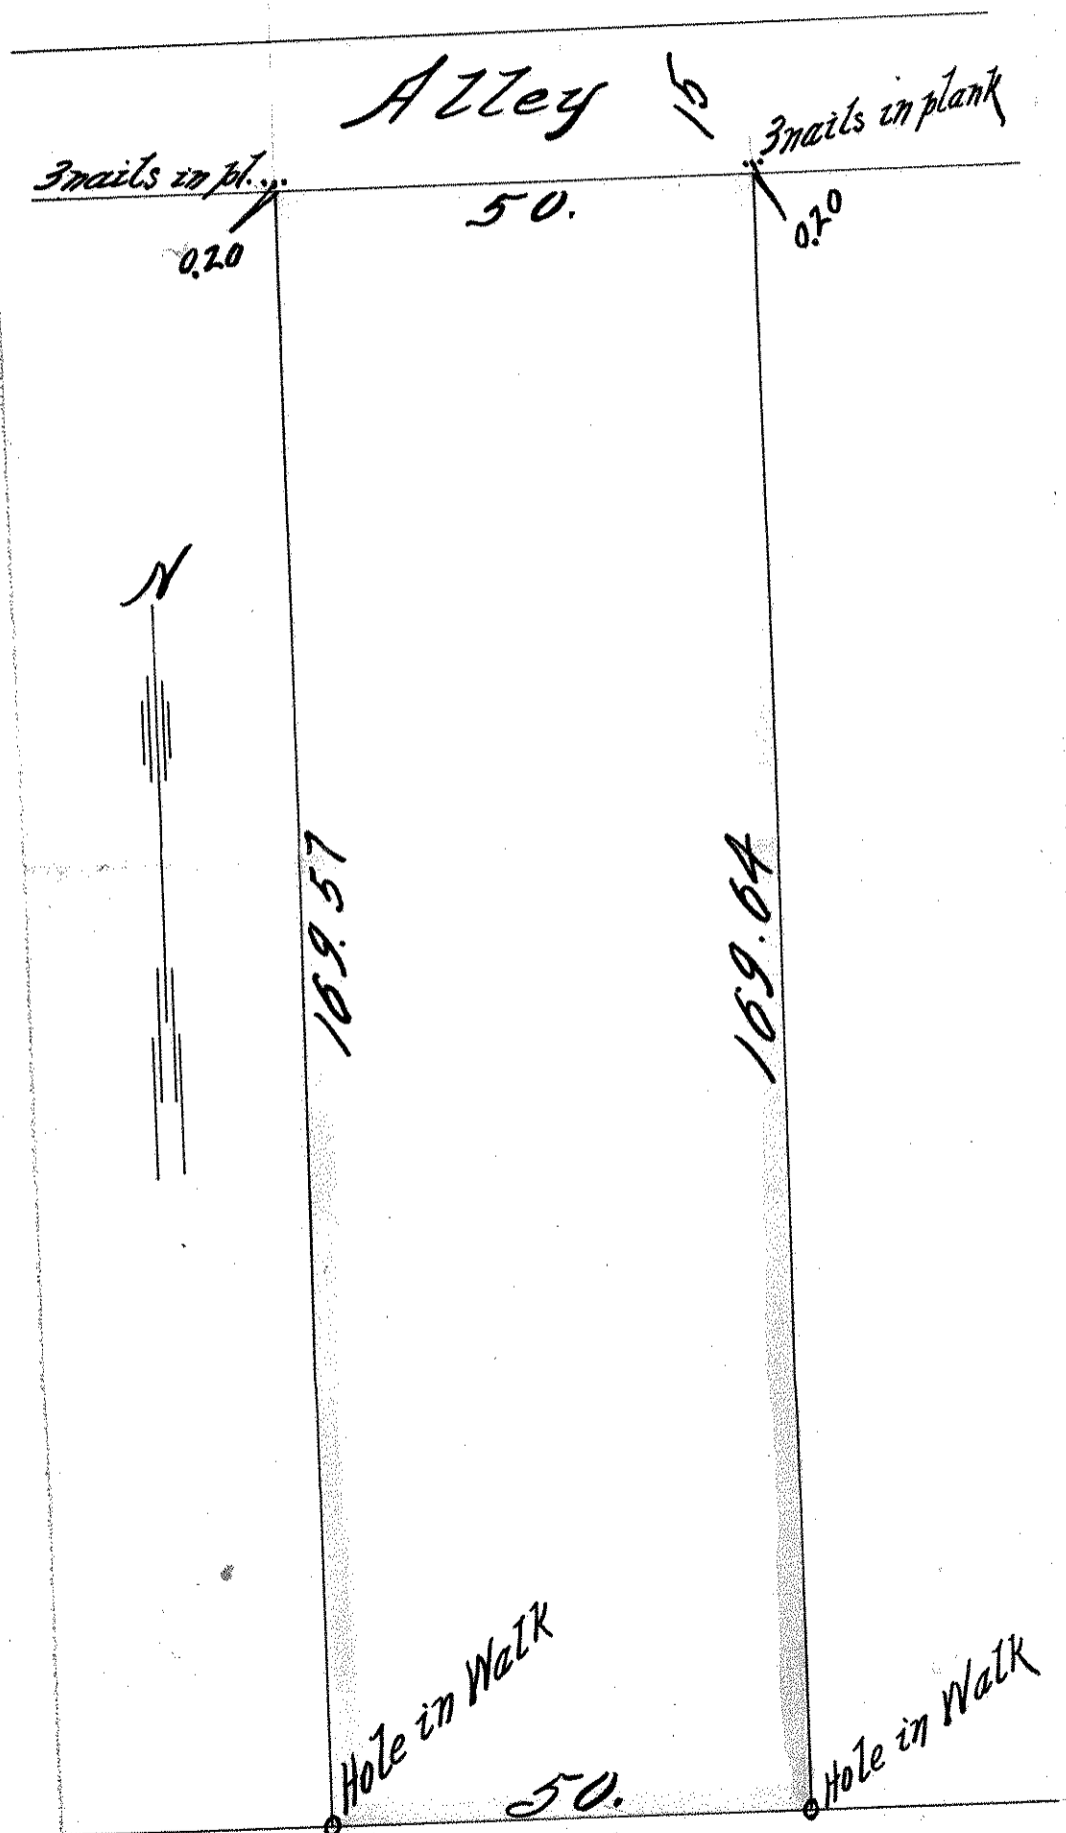

DAYTON AVE. 66

B.47.P.51