St. Paul Minn. Jan. 17th 1903

I hereby certify that this diagram correctly represents a part of Lot 2 Crocus Hill 3rd Rear. of Block 1, Wright's Add as the same was surveyed by me this day.
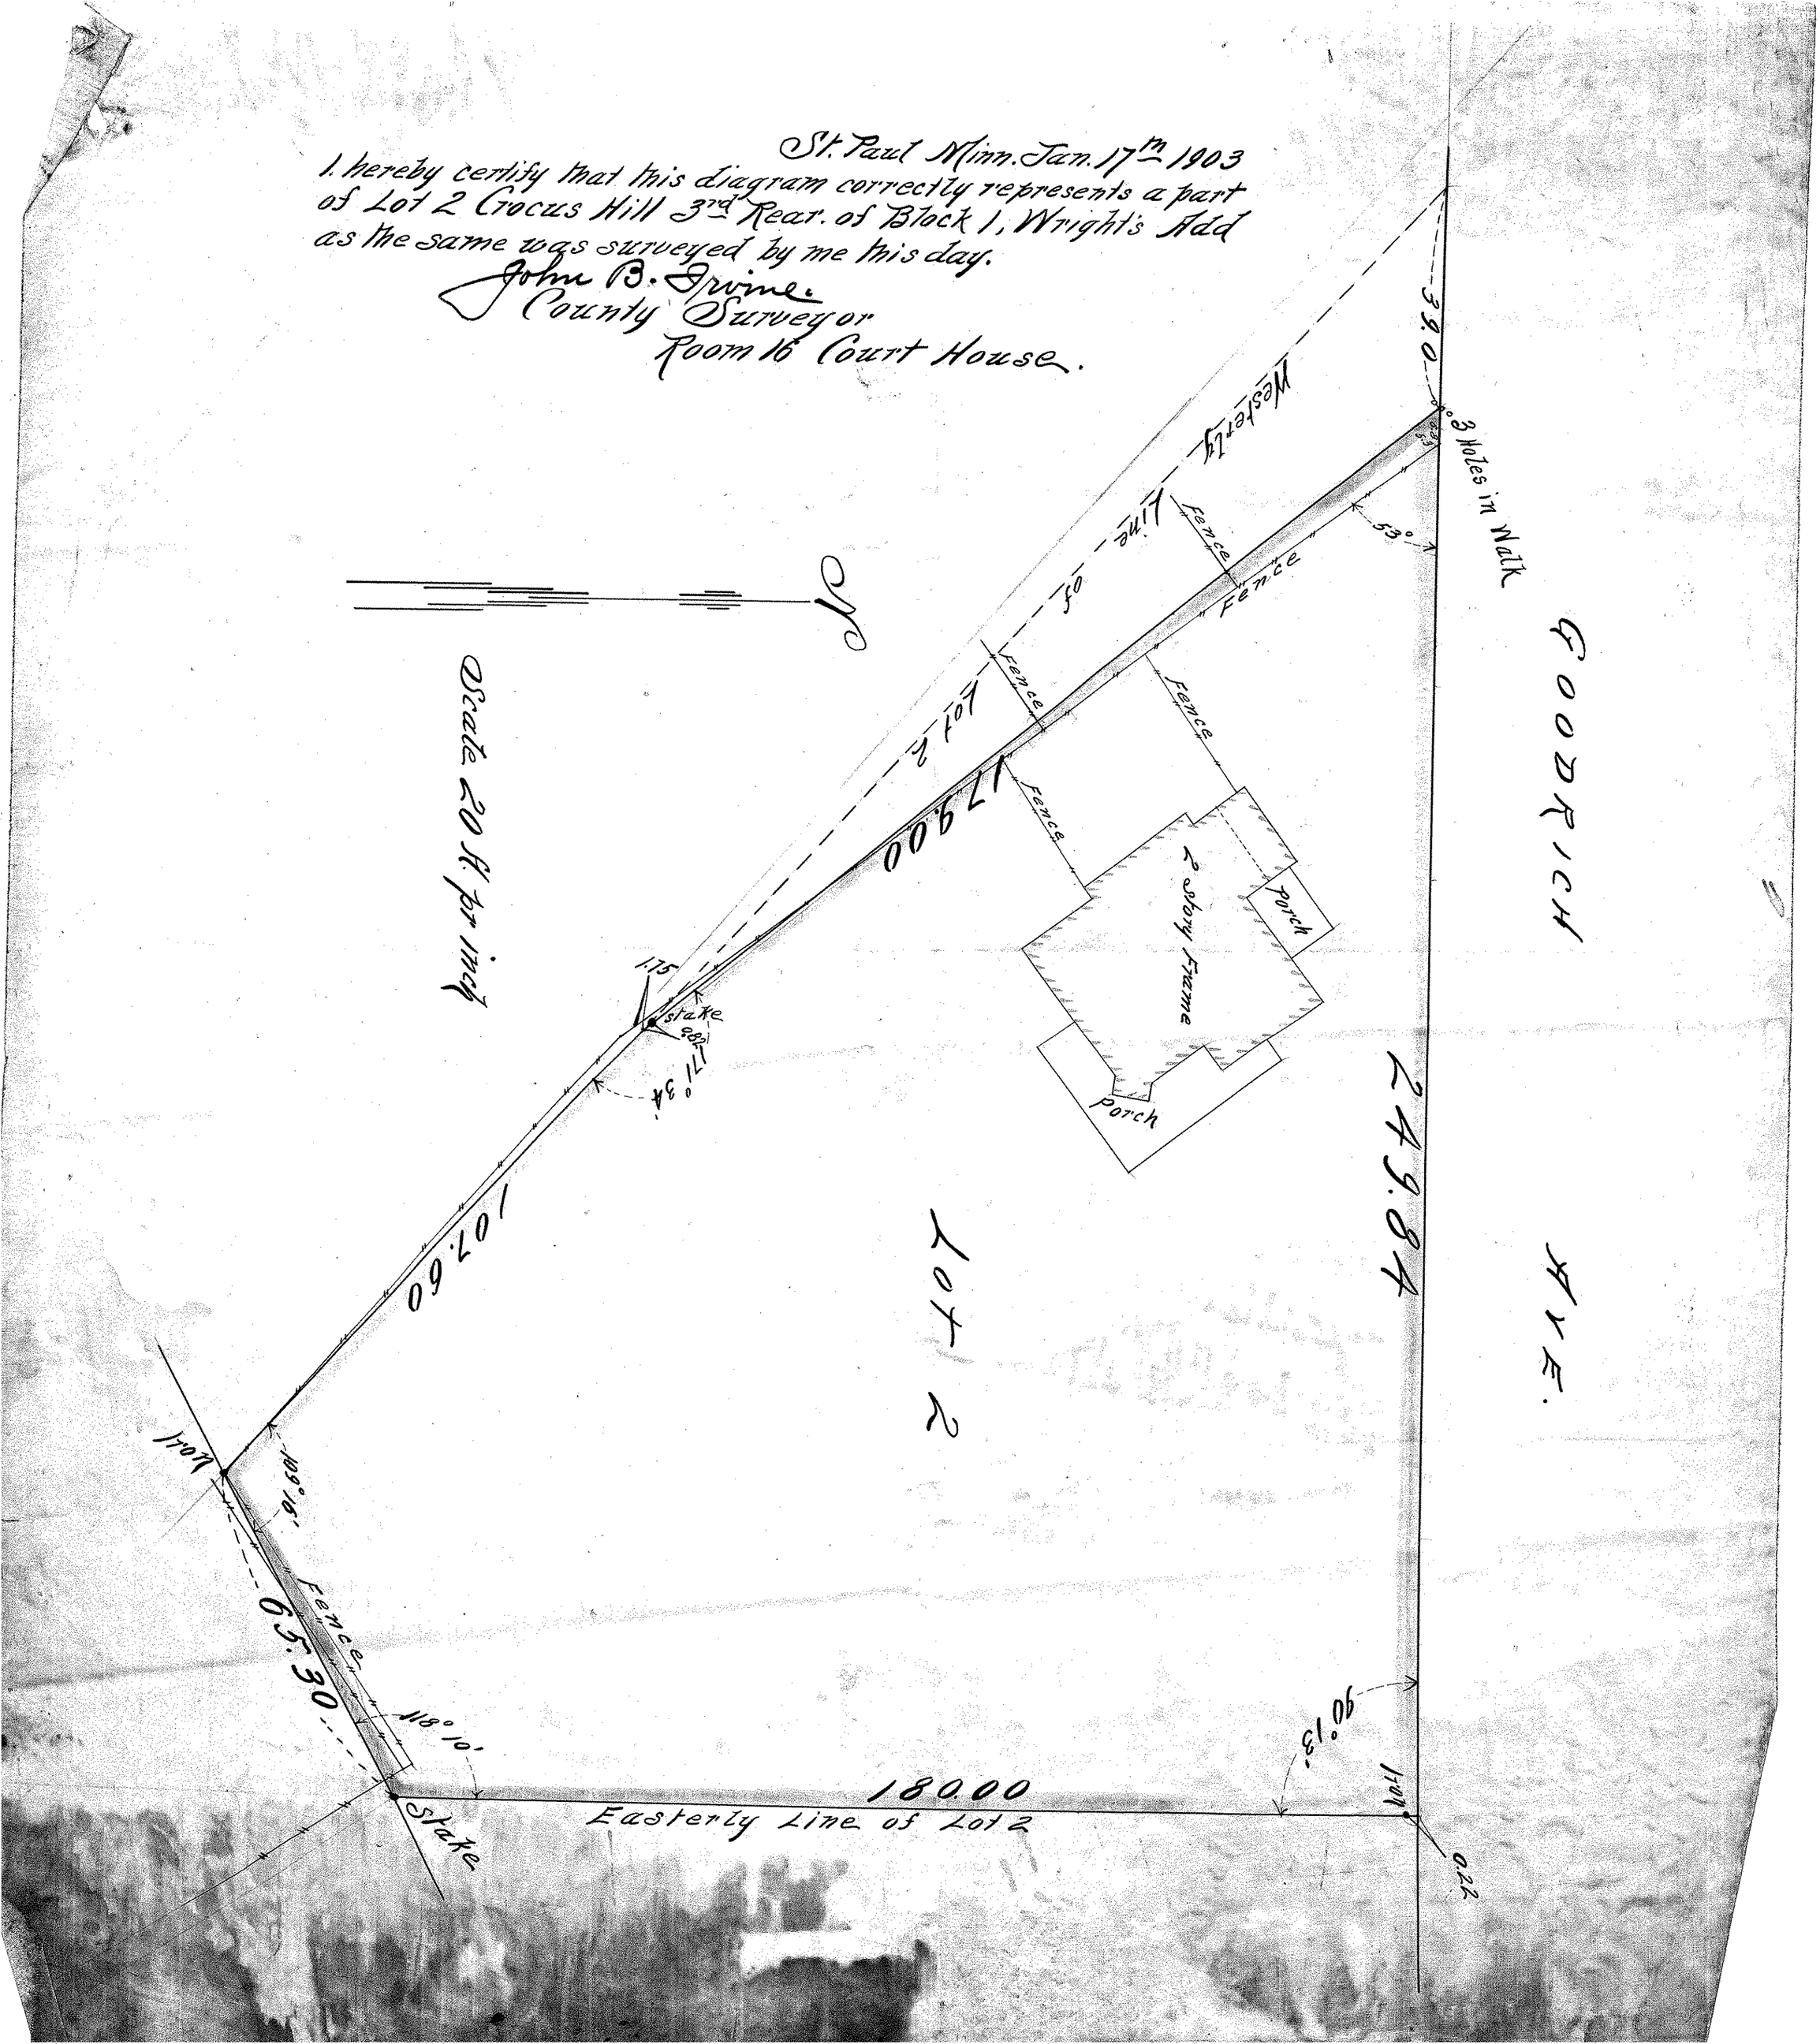
John B. Irvine.
County Surveyor
Room 16 Court House.