


LOT 2 BLOCK 1
WRIGHT'S REAR,
ANNA E. RAMSEY'S
ADD.

JOHN B. IRVINE SURVEYOR
416 GLOBE BLDG.
ST PAUL MINN.
MCH 23-07

SCALE 20ft. per inch.

PORTLAND AV.

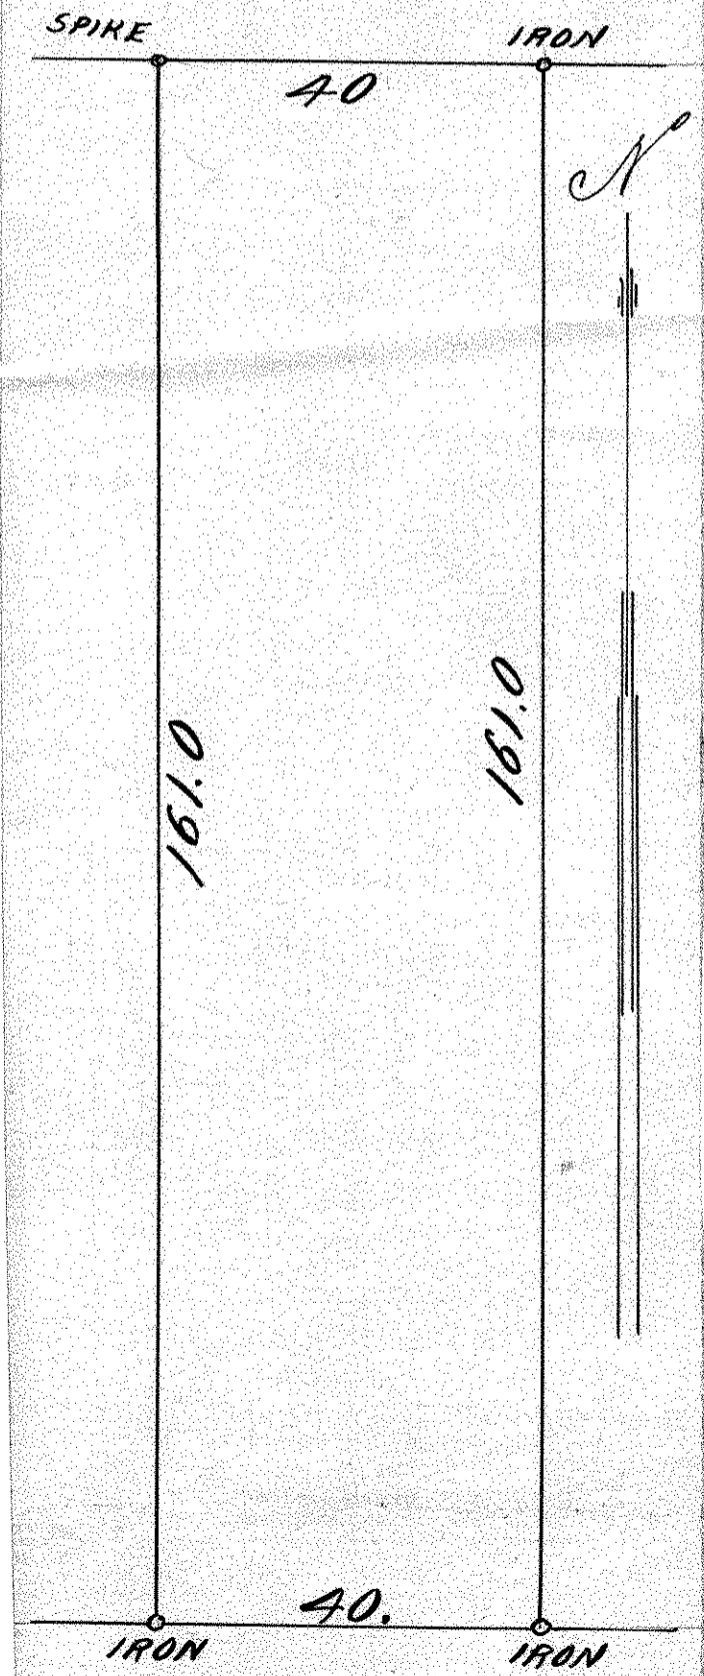

ALLEY 20

