


LOT 6 BLOCK 1
WRIGHT'S RE-AG
ANNA E. RAMSEY'S ADD.

JOHN B. IRVINE, SURVEYOR,
ROOM. 508 GLOBE BLDG.
ST PAUL, MINN.

SCALE 1/4" = 20 FT.

MAY 29-05.

PORTLAND AVE.

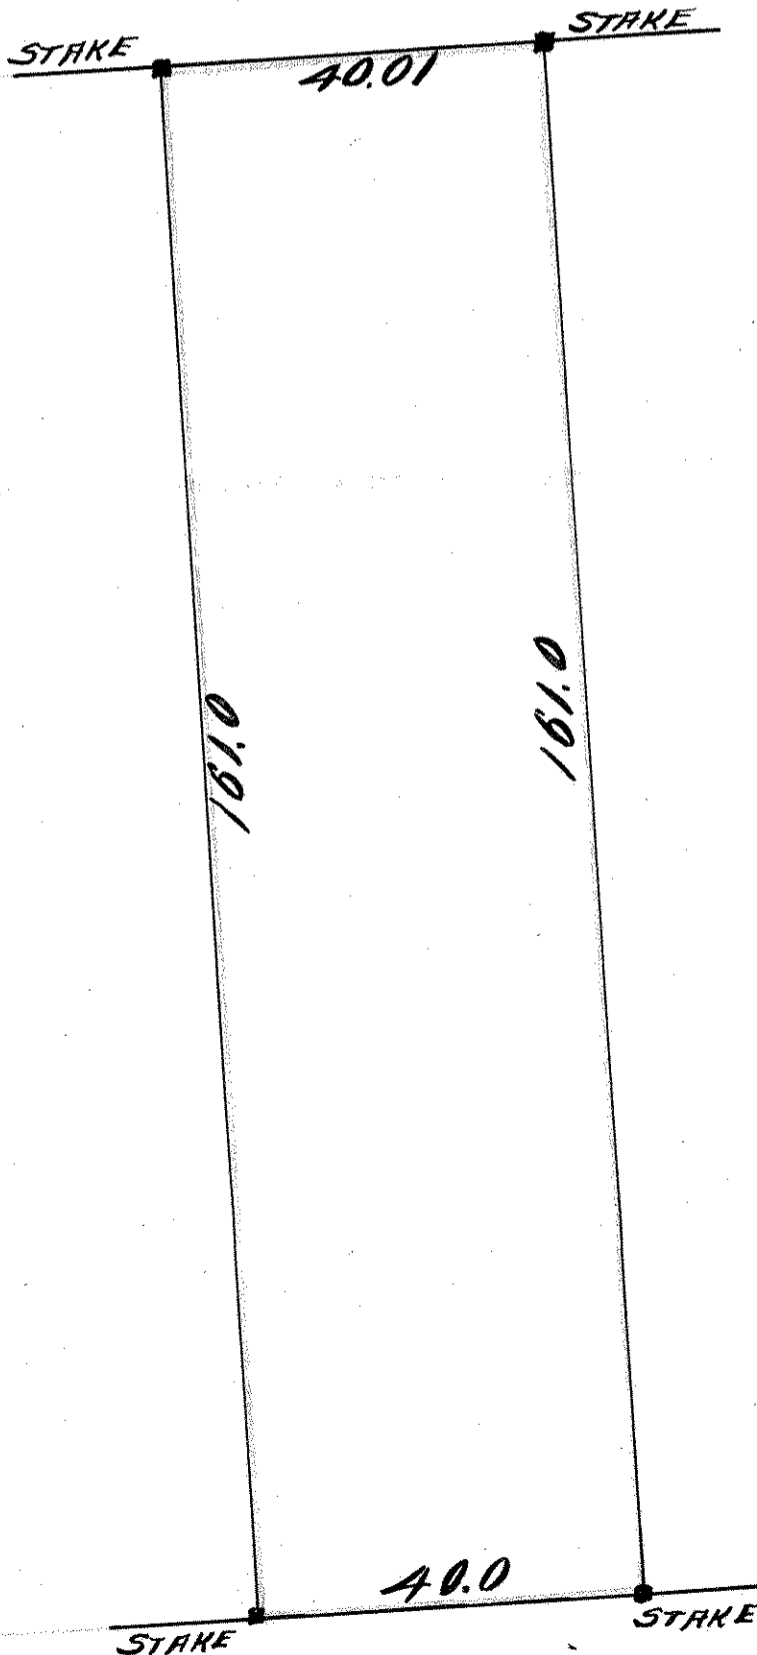

ALLEY 20.