


**LOT II WRIGHT'S RE-AR
BLK. I A. E. RAMSEY ADD.**

JOHN B. IRVINE SURVEYOR.
ROOM 406 GLOBE BLDG.
ST PAUL MINN.
NOV. 11-05.

SCALE 1/4 IN. = 20 FT.

PORTLAND AVE.

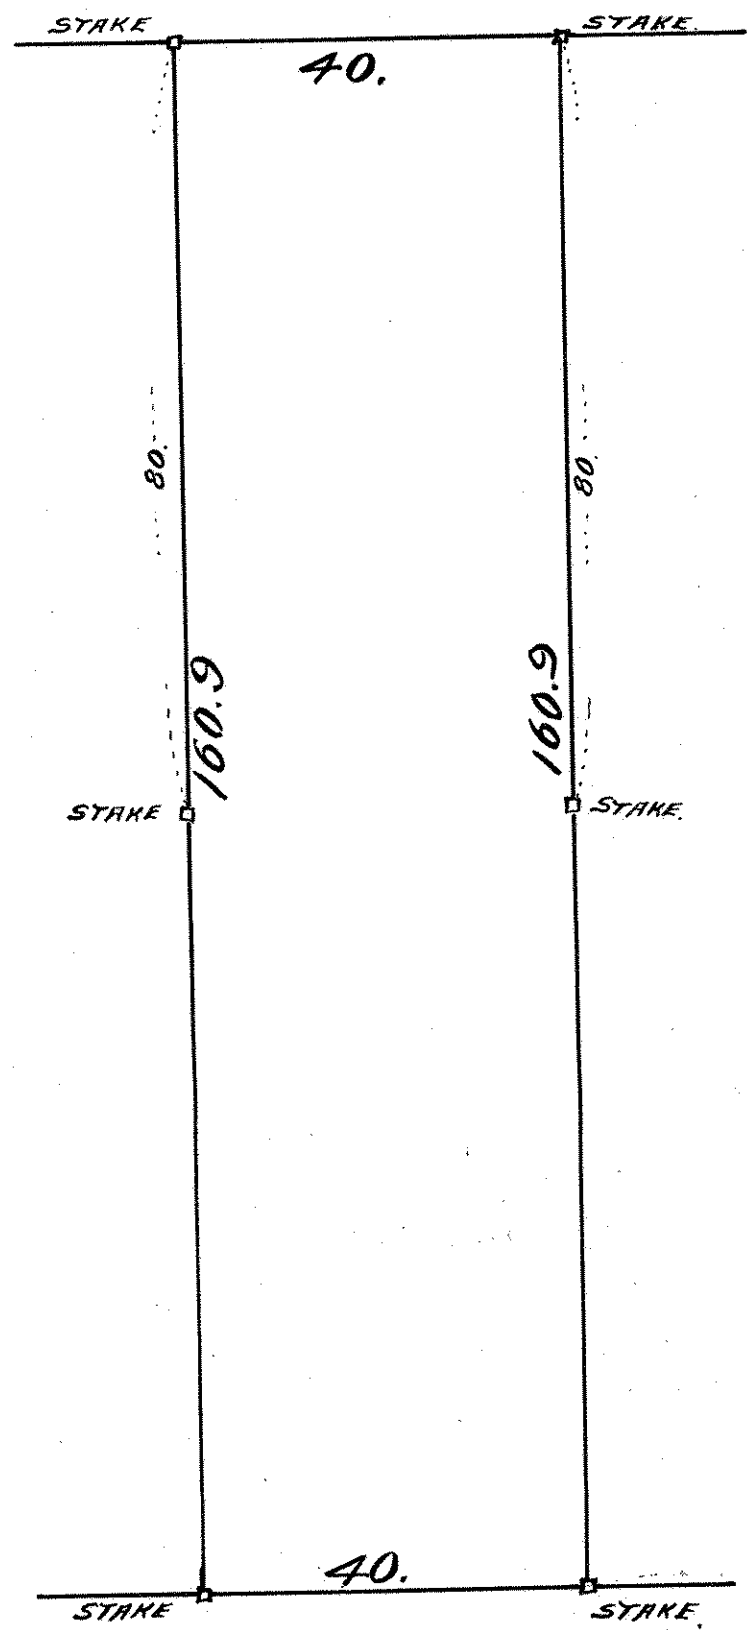

ALLEY. 20