


LOT 9 BLOCK 2.
WRIGHT'S RE-ARR.
ANNA E. RAMSEY'S ADD.

JOHN B. IRVINE SURVEYOR.
416 GLOBE BLDG.
ST PAUL MINN.

SCALE 1 IN. = 20 FT. SEPT. 11th 1906

PORTLAND AVE.

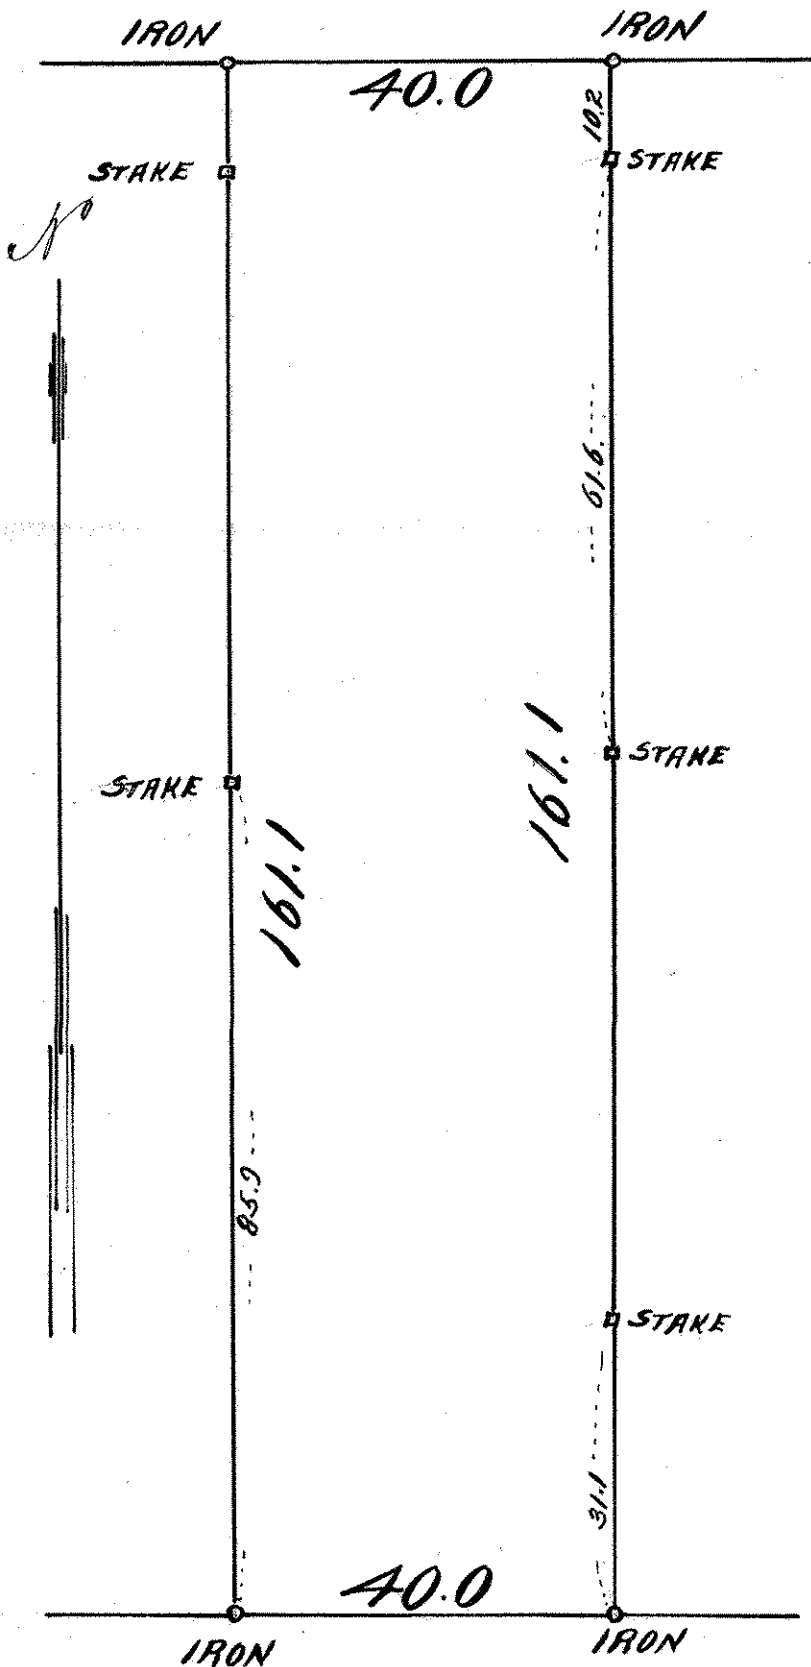

ALLEY 20'