LOTS 3 & 4 BLOCK 1.

WRIGHT & WILLIAM'S RE-AR

BLOCK 12.

MACALESTER PARK.
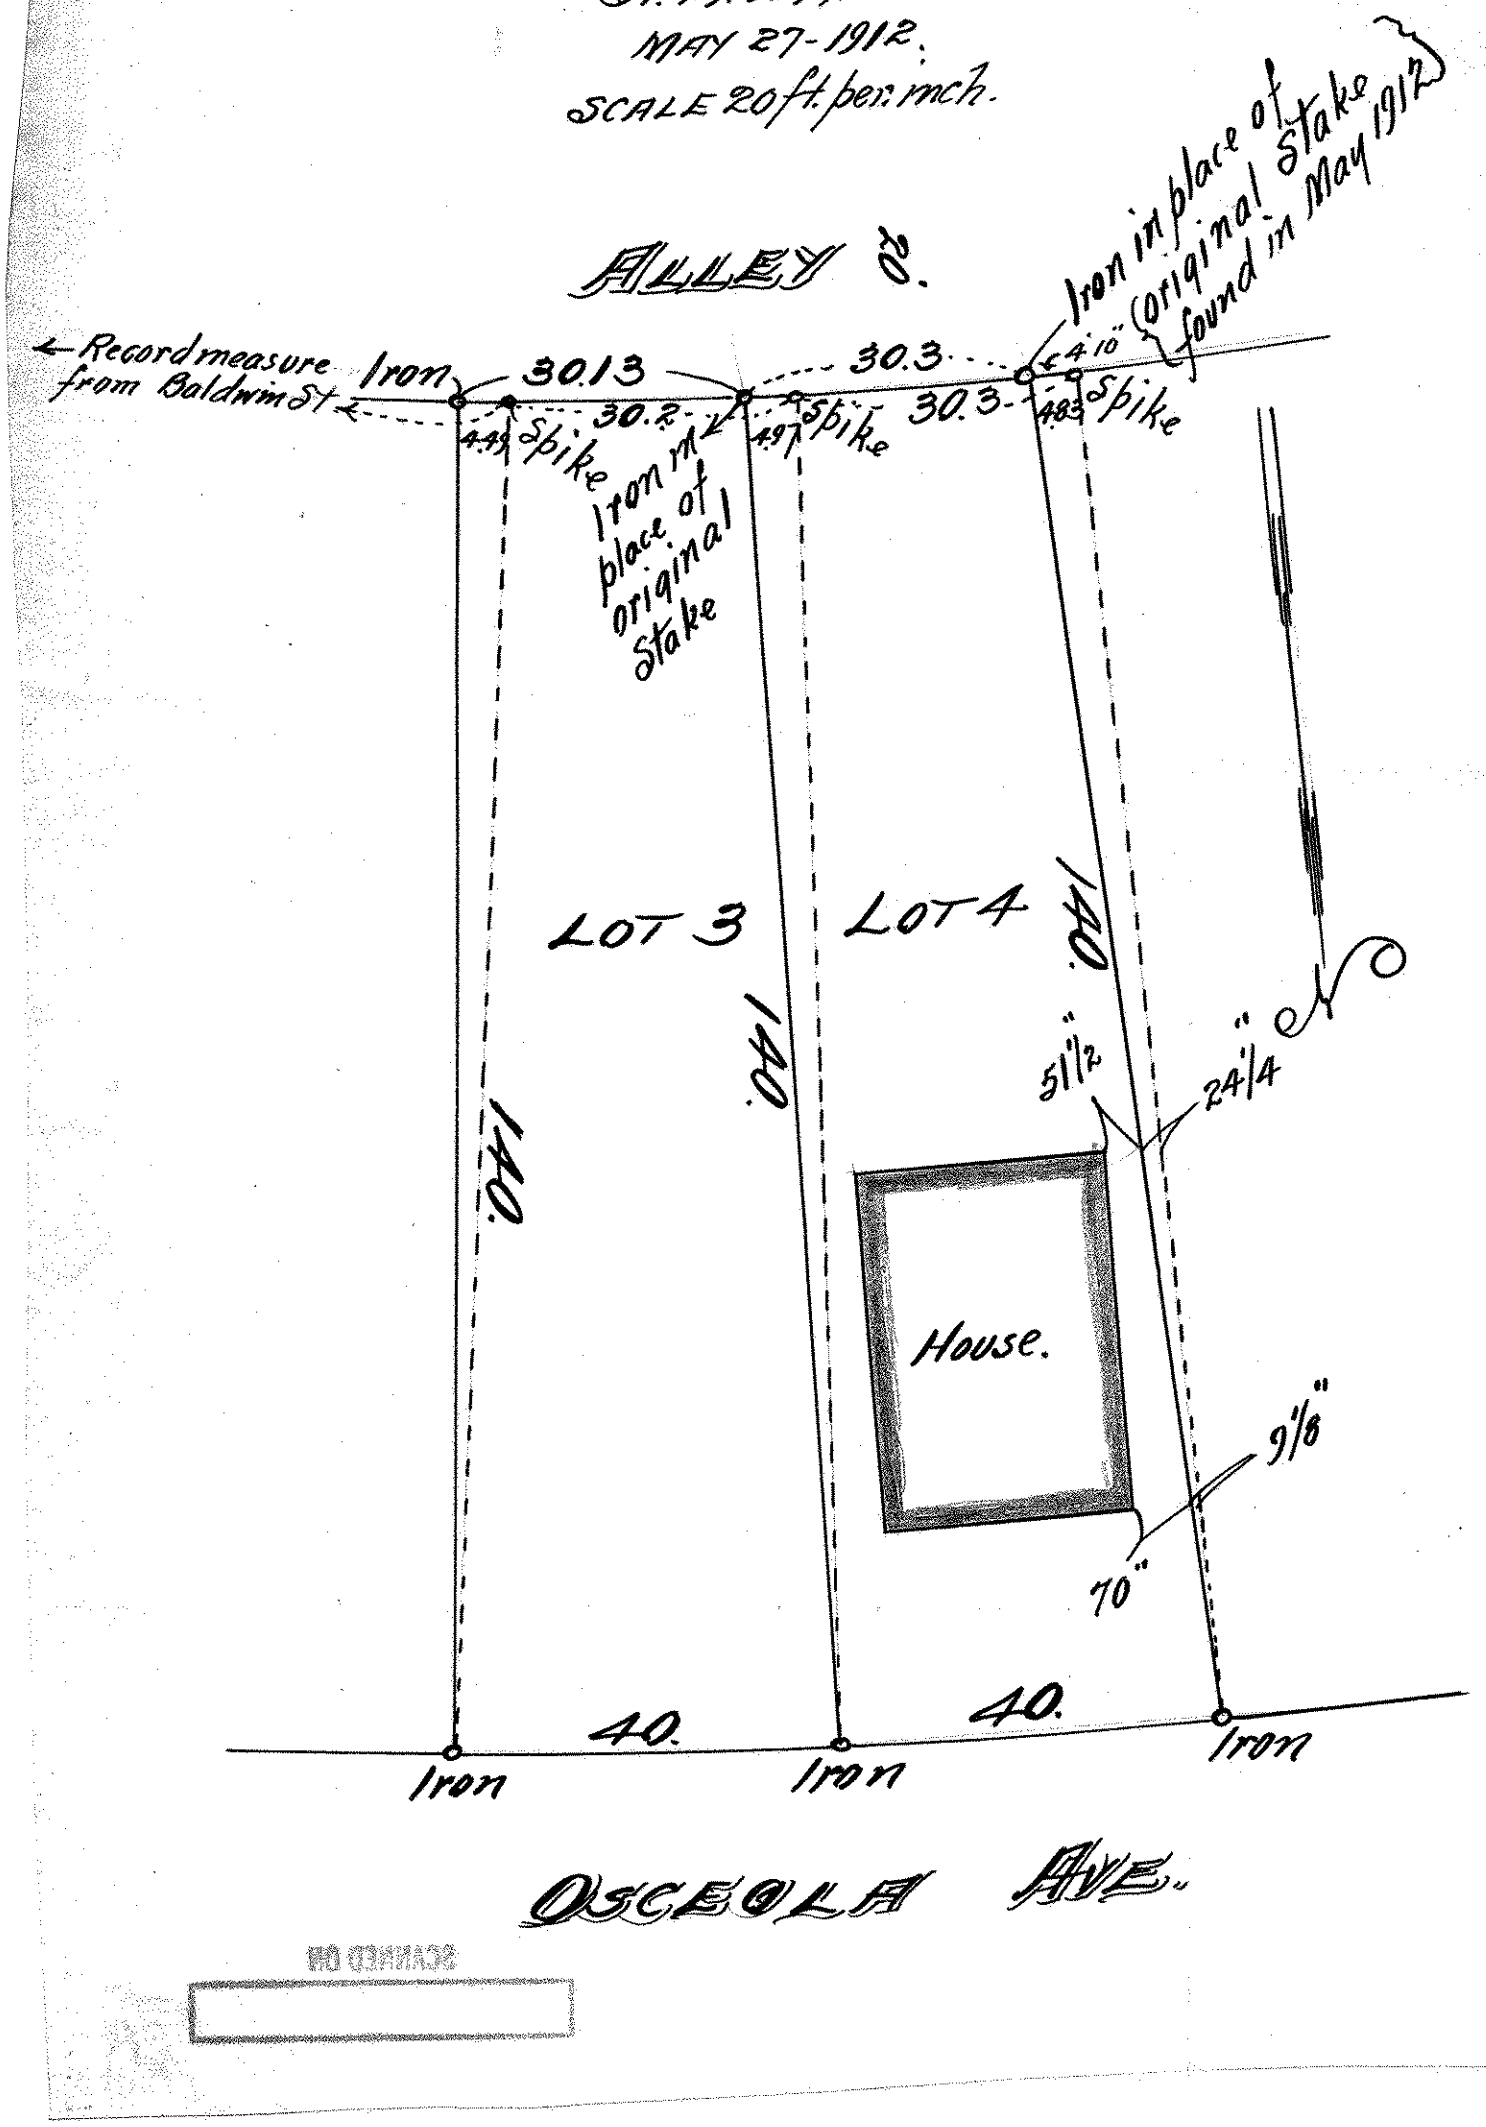
JOHN B. IRVINE, SURVEYOR.
408 GLOBE BLD'G.
ST. PAUL, MINN.
MAY 27-1912.
SCALE 20 ft. per inch.