SURVEY OF SW¼SE¼ SEC. 17 T. 28N., R. 23W.
FOR
C.O. GEORGI

Wayne M. Logan
3/13/69 3559

SCALE: 1"=100'
MARCH 1969
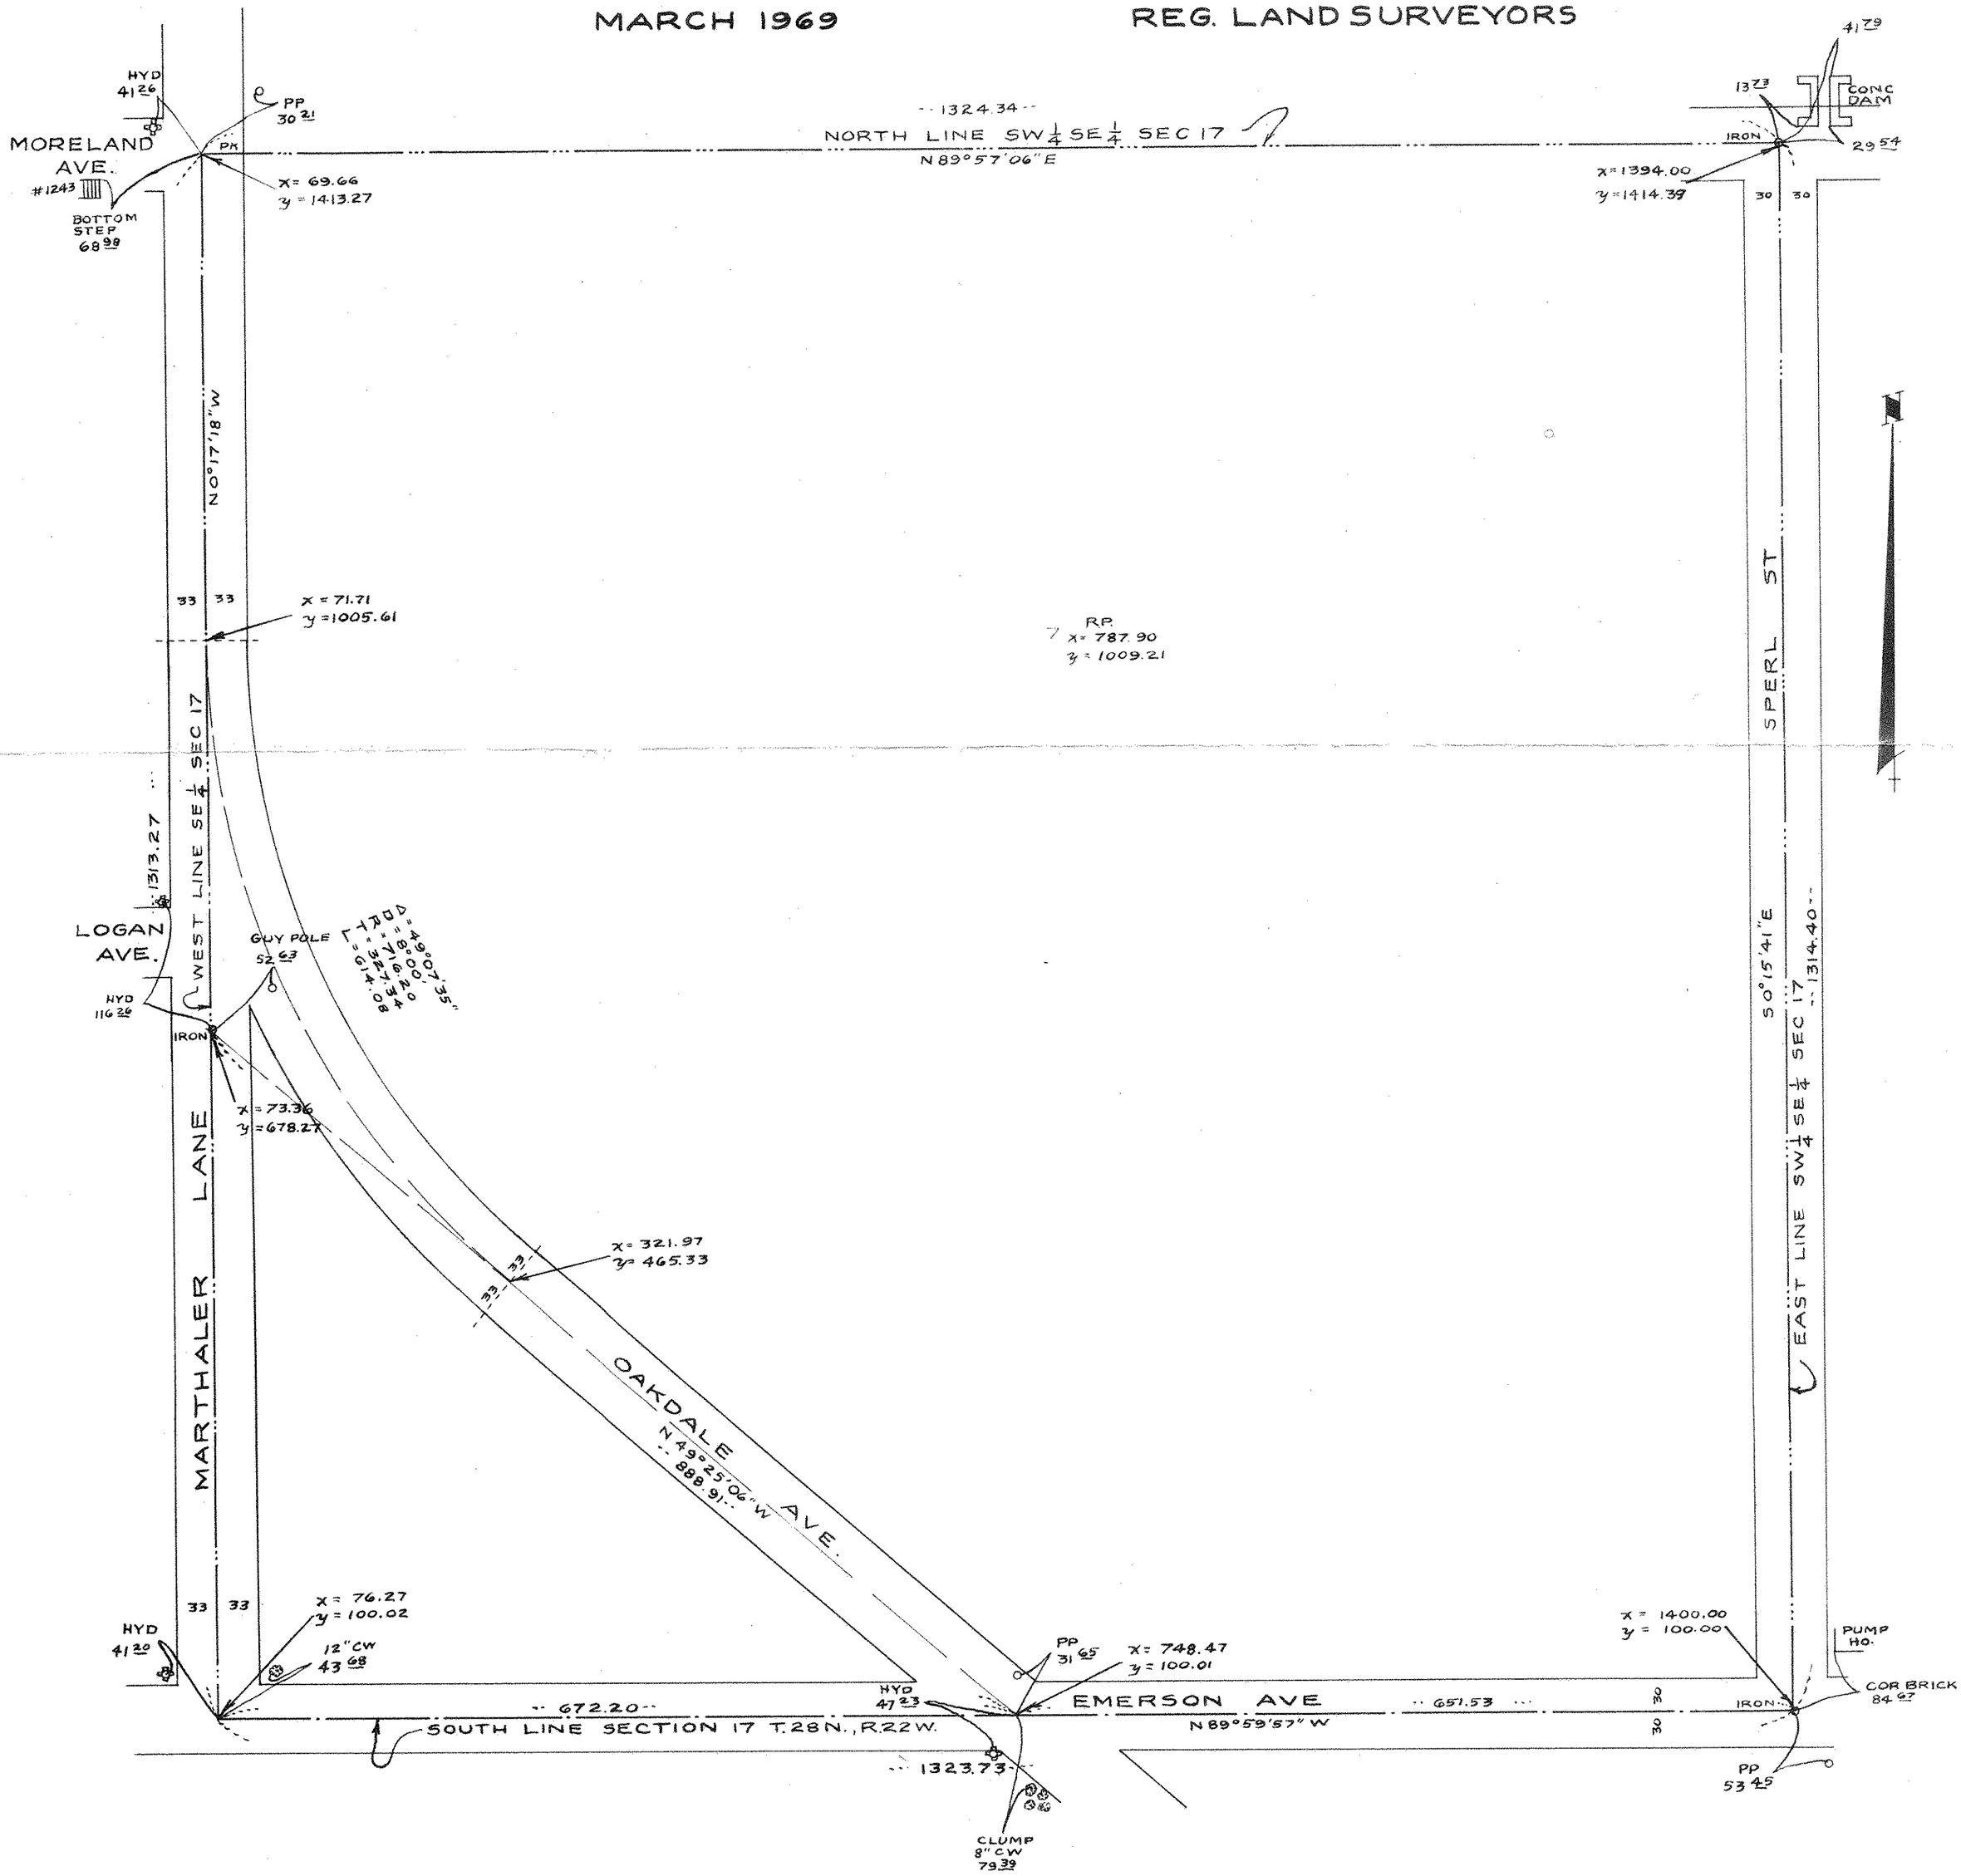
PAUL McLAGAN & SON
REG. LAND SURVEYORS