


# STIEPANS GARDEN LOTS

DEC-1924

CTR-SEC-16-29-23

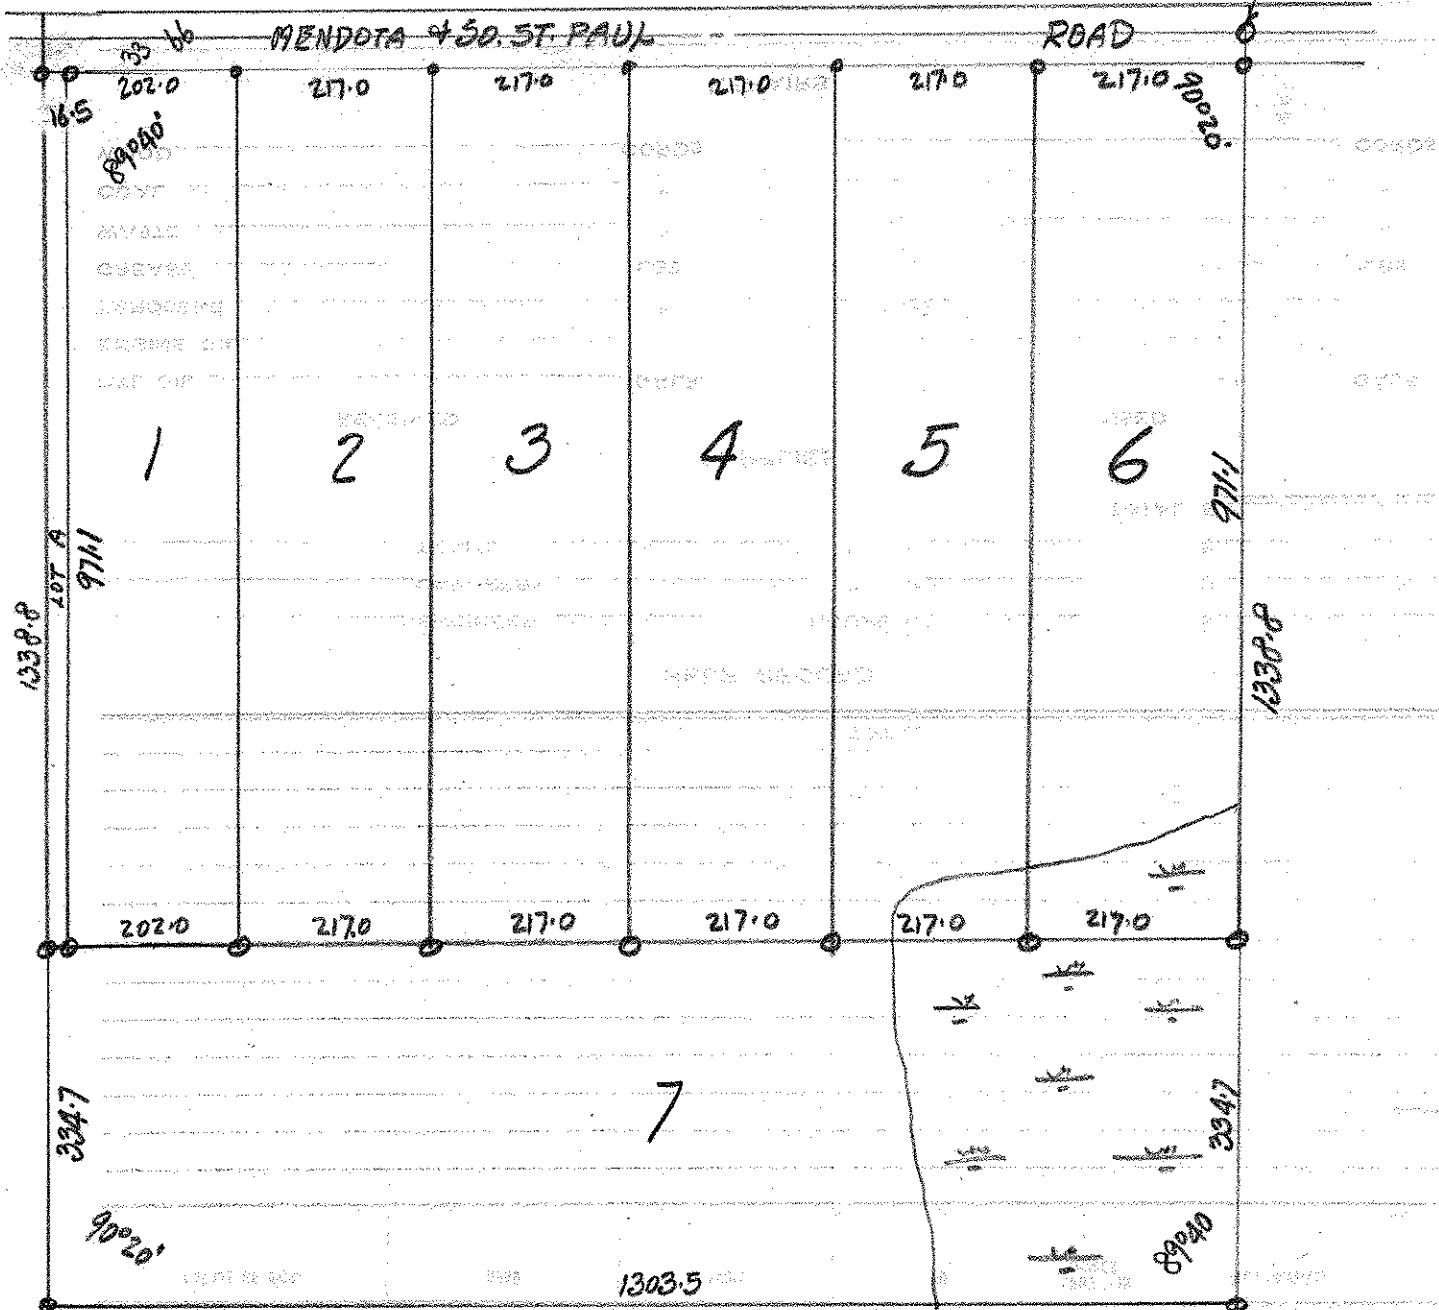

NOTHING TO

BY

185



