

179° 55' 11402.17
60.0


3rd St

445.03

309.11 310.03
310.01

75.0
2001 55.0

179° 54' 15447.2
HOLE 11.99

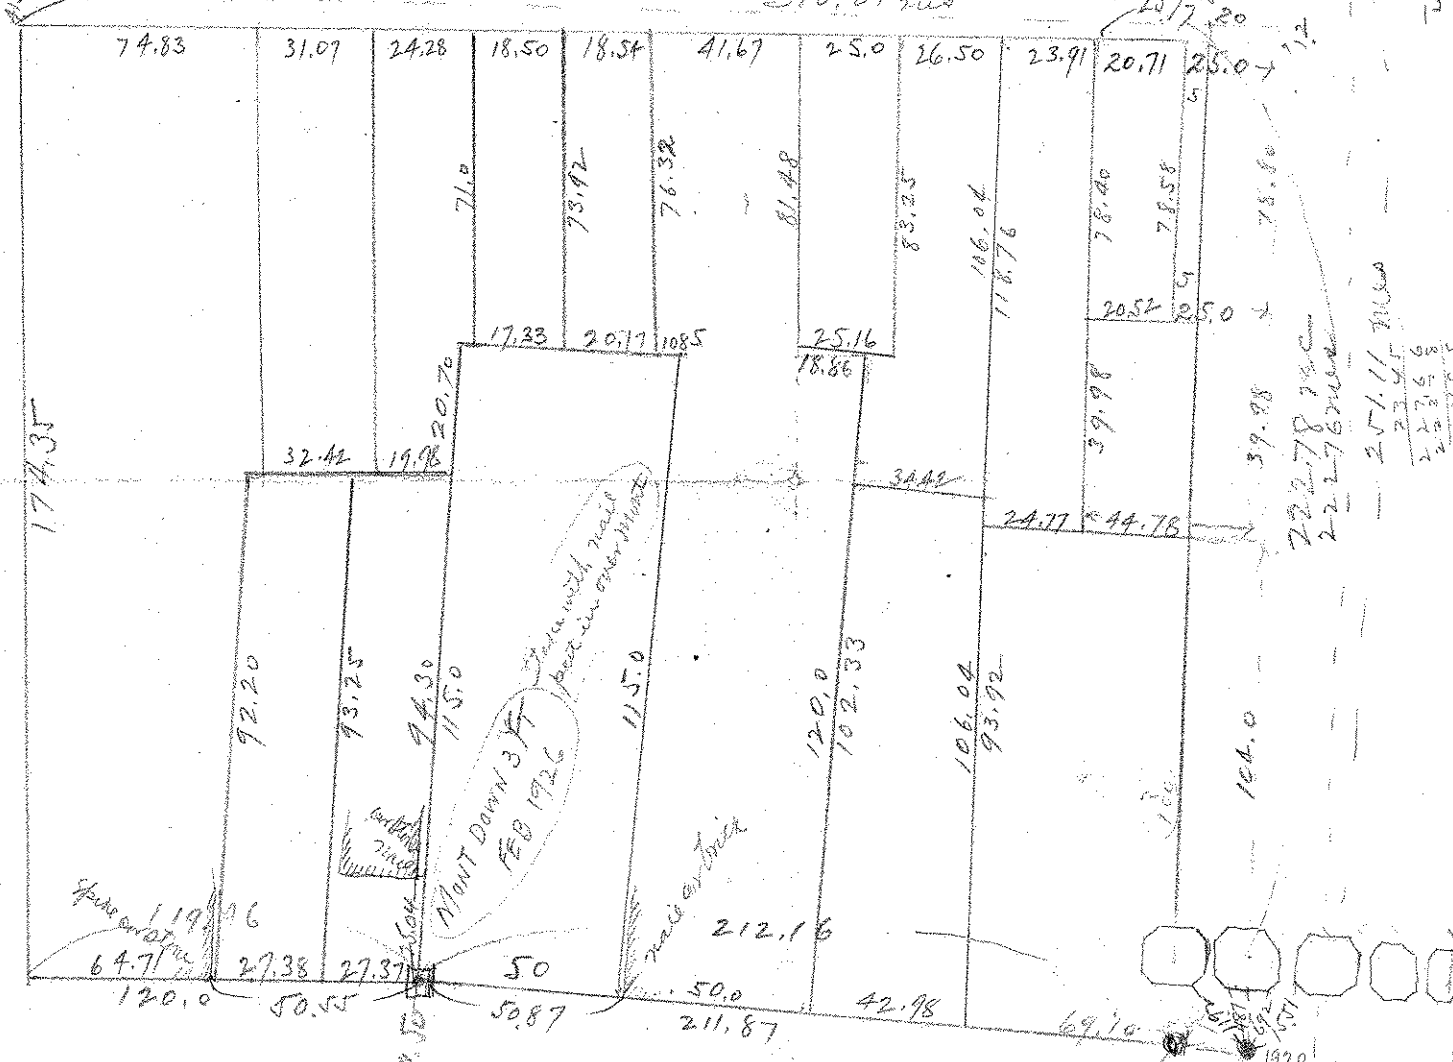

Robert

44503
60
38503
312

113
7483
3107
2428
1850
1854
4167
2500
2650
2391
2071
500
31001
3006
33001
553

14295
6919
2213

2nd St

14288
6919
2213