

86.3 Denotes Elev. 286.3
P.P. Power Pole
L.P. Street Light Pole

NOTE:

All Elevations City Datum
B.M. Top Hyd. NW Cor. S. Robert St and Wentworth Ave. 288.98
Underground Electric along East-West power pole line on
South side of Wentworth Ave., abandoned in place
No soil test holes were made and no apparent unusual
soil conditions were visible.
All Utilities per public record and to accuracy of same.

DESCRIPTION:

Lots 4, 5, 6 and 7 in Block 1 of Erchingers Addition to
South St. Paul, Dakota County, Minnesota


This is to certify that this map shows a survey made by me of
the property described herein, and that the corners are correctly
placed as shown, and that all locations and elevations have been
correctly shown.

Charles O. Georgi
Registered Land Surveyor
No. 3960

TEXACO

**SERVICE STATION - S. ROBERT STREET
& WENTWORTH AVE.
WEST ST. PAUL, MINN.**

Charles O. Georgi Company
Civil Engineering & Land Surveying
2215 W. Co. Rd. B, St. Paul 13, Minn.
June 1962

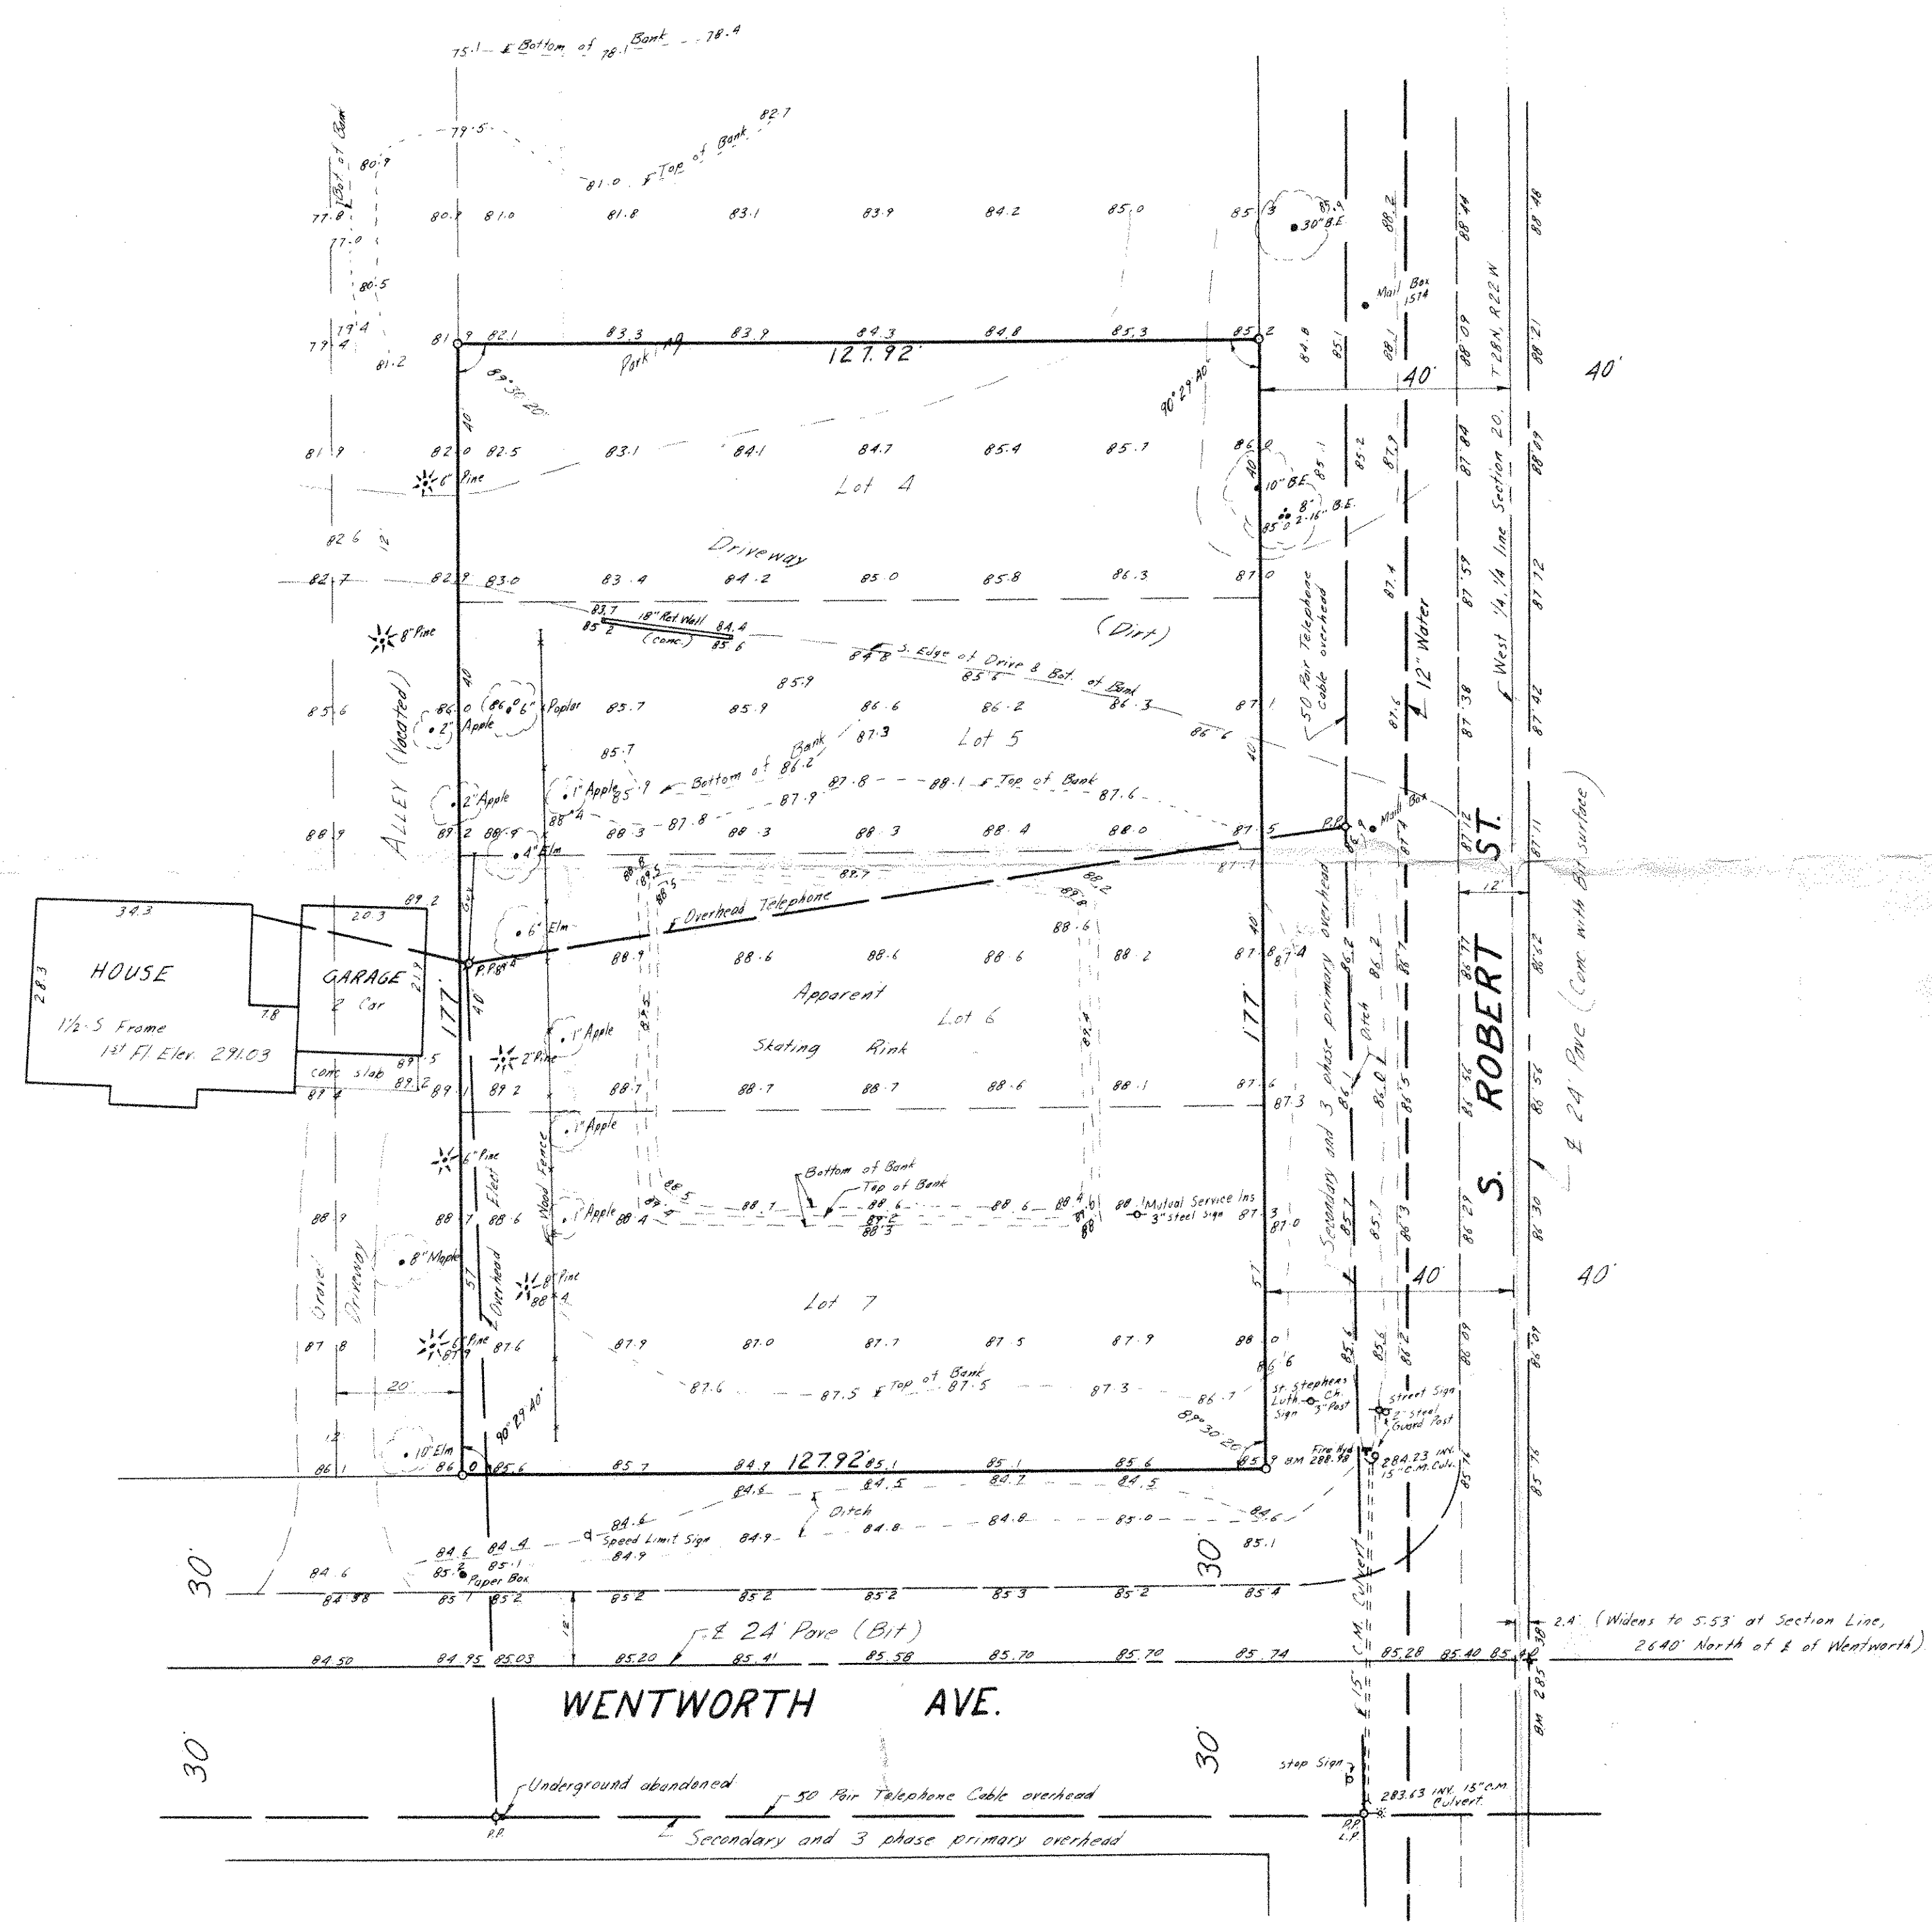

○ Denotes Iron Monument

SCALE 1"=20'