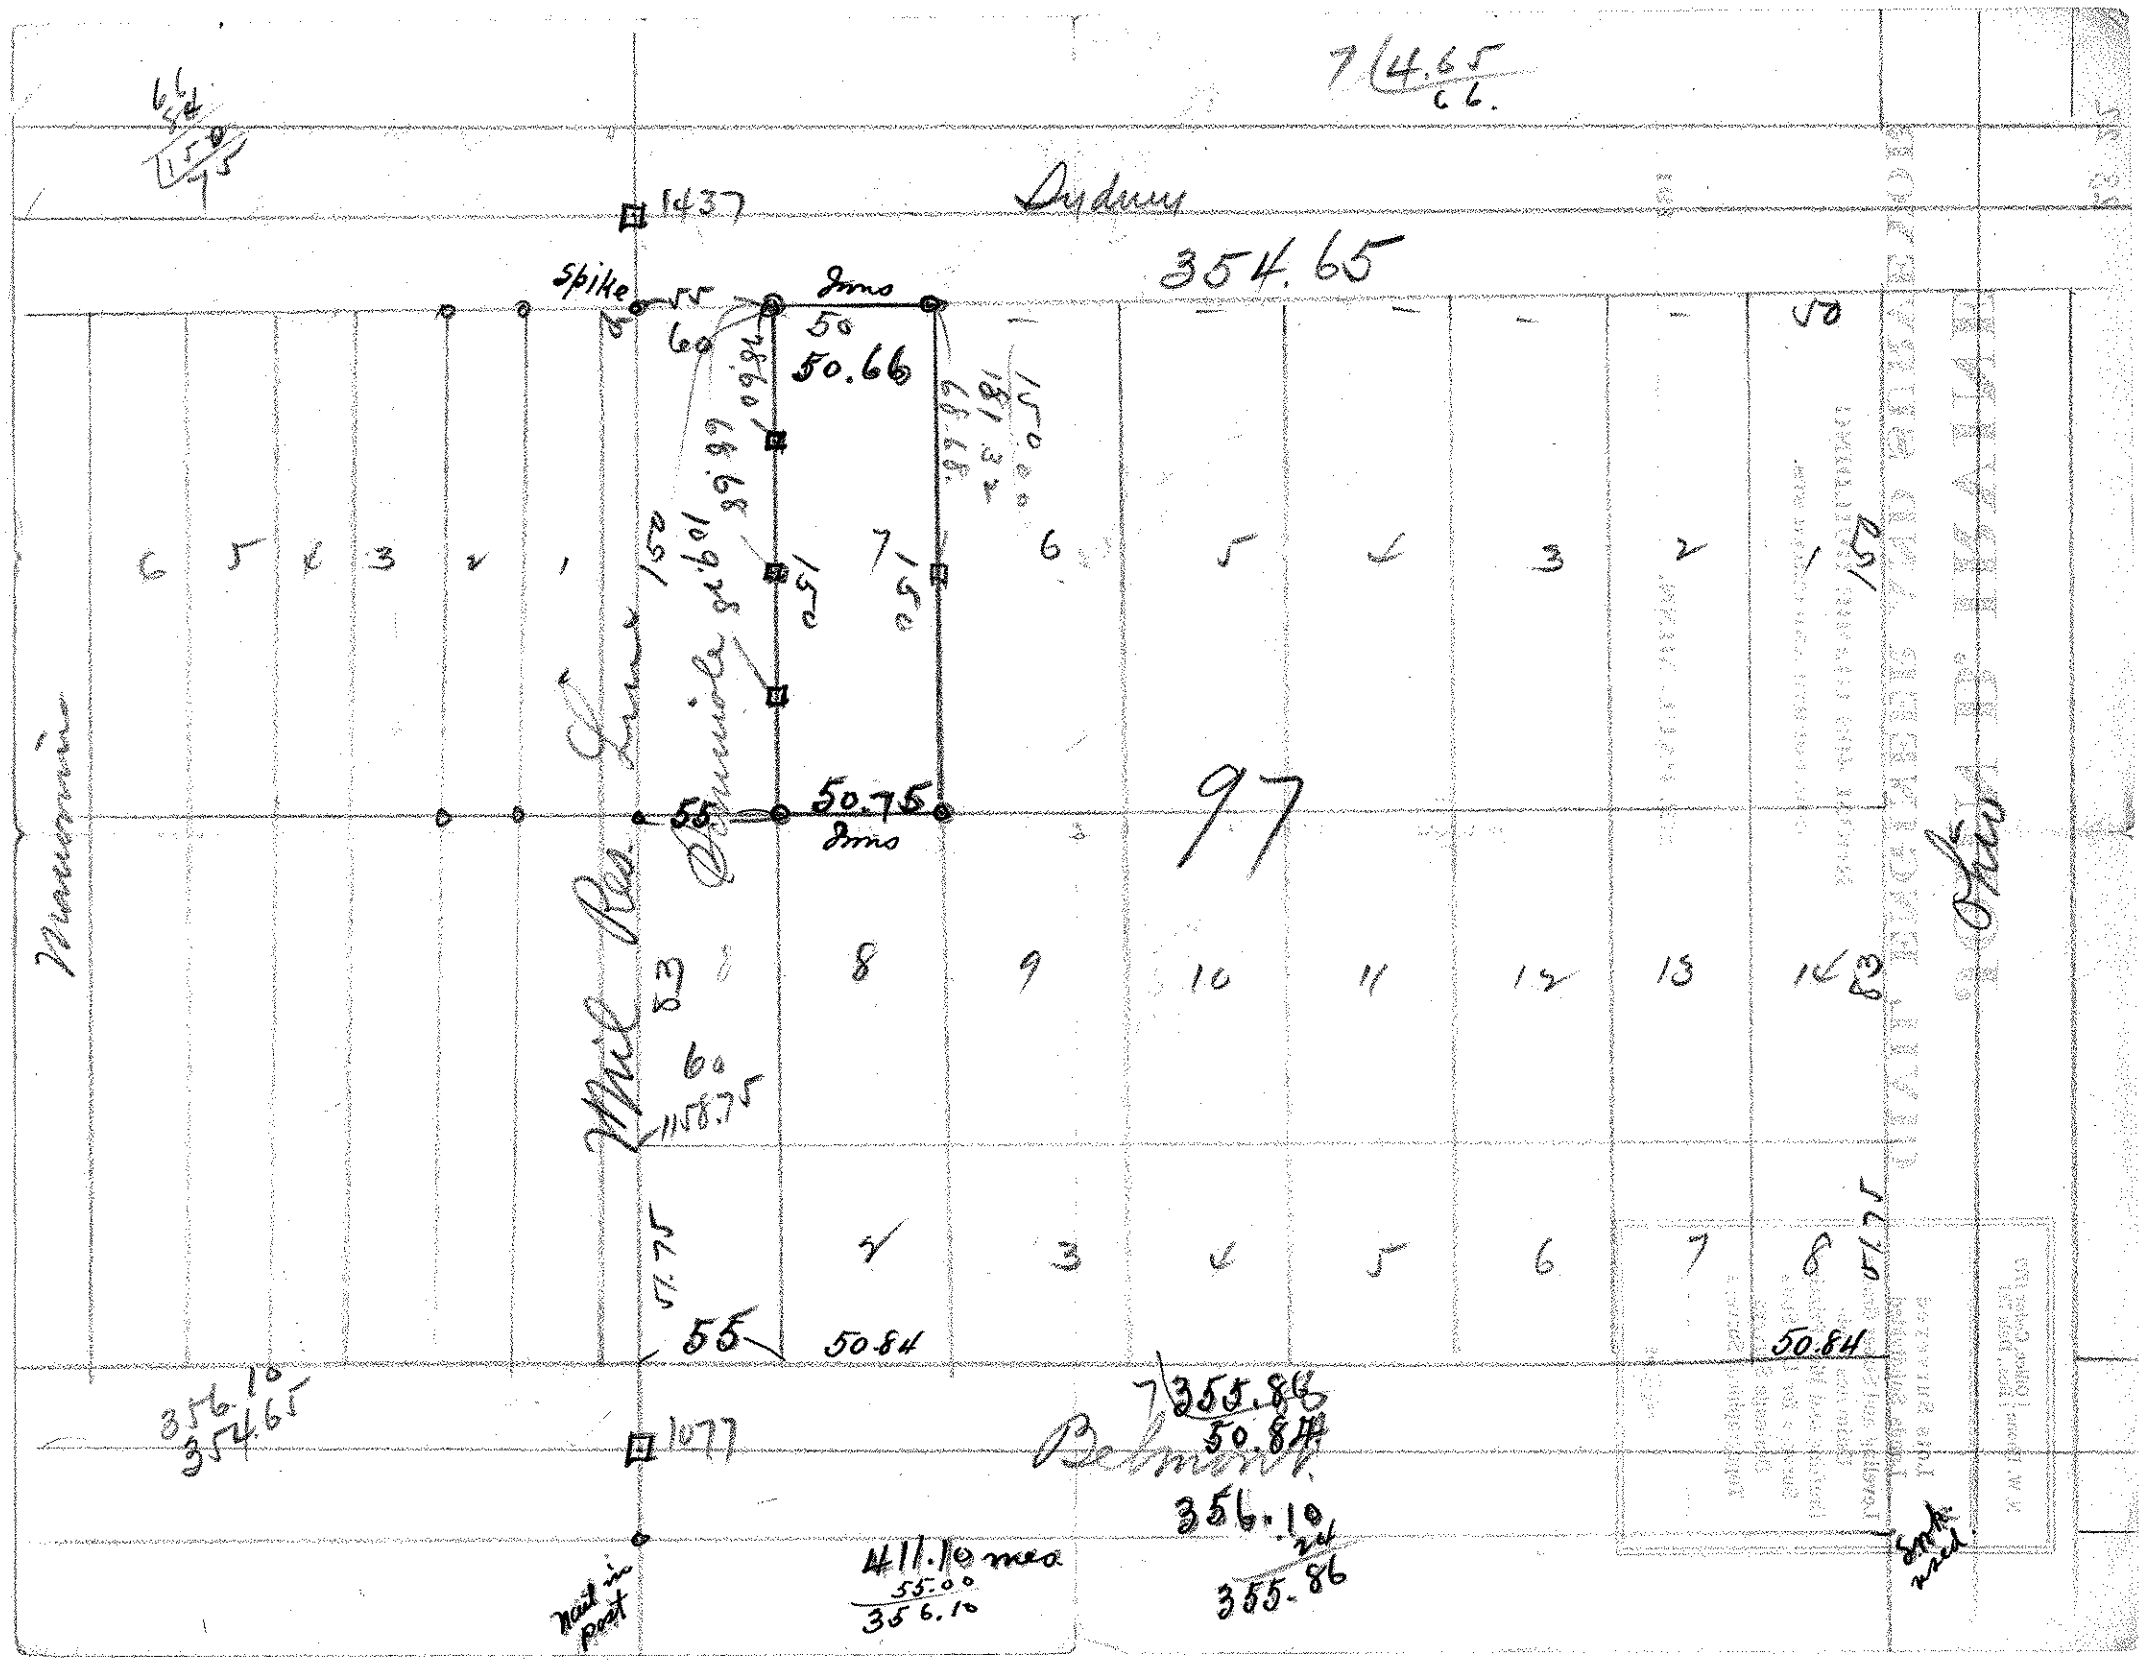
Sydney
Spike
Belmont
1437
1077
354.65
97
50.66
50.75
50.84
411.10 mea
356.10
355.86
355.86
50.84
356.10
354.65
356.10
355.86
nail in post
Spike used