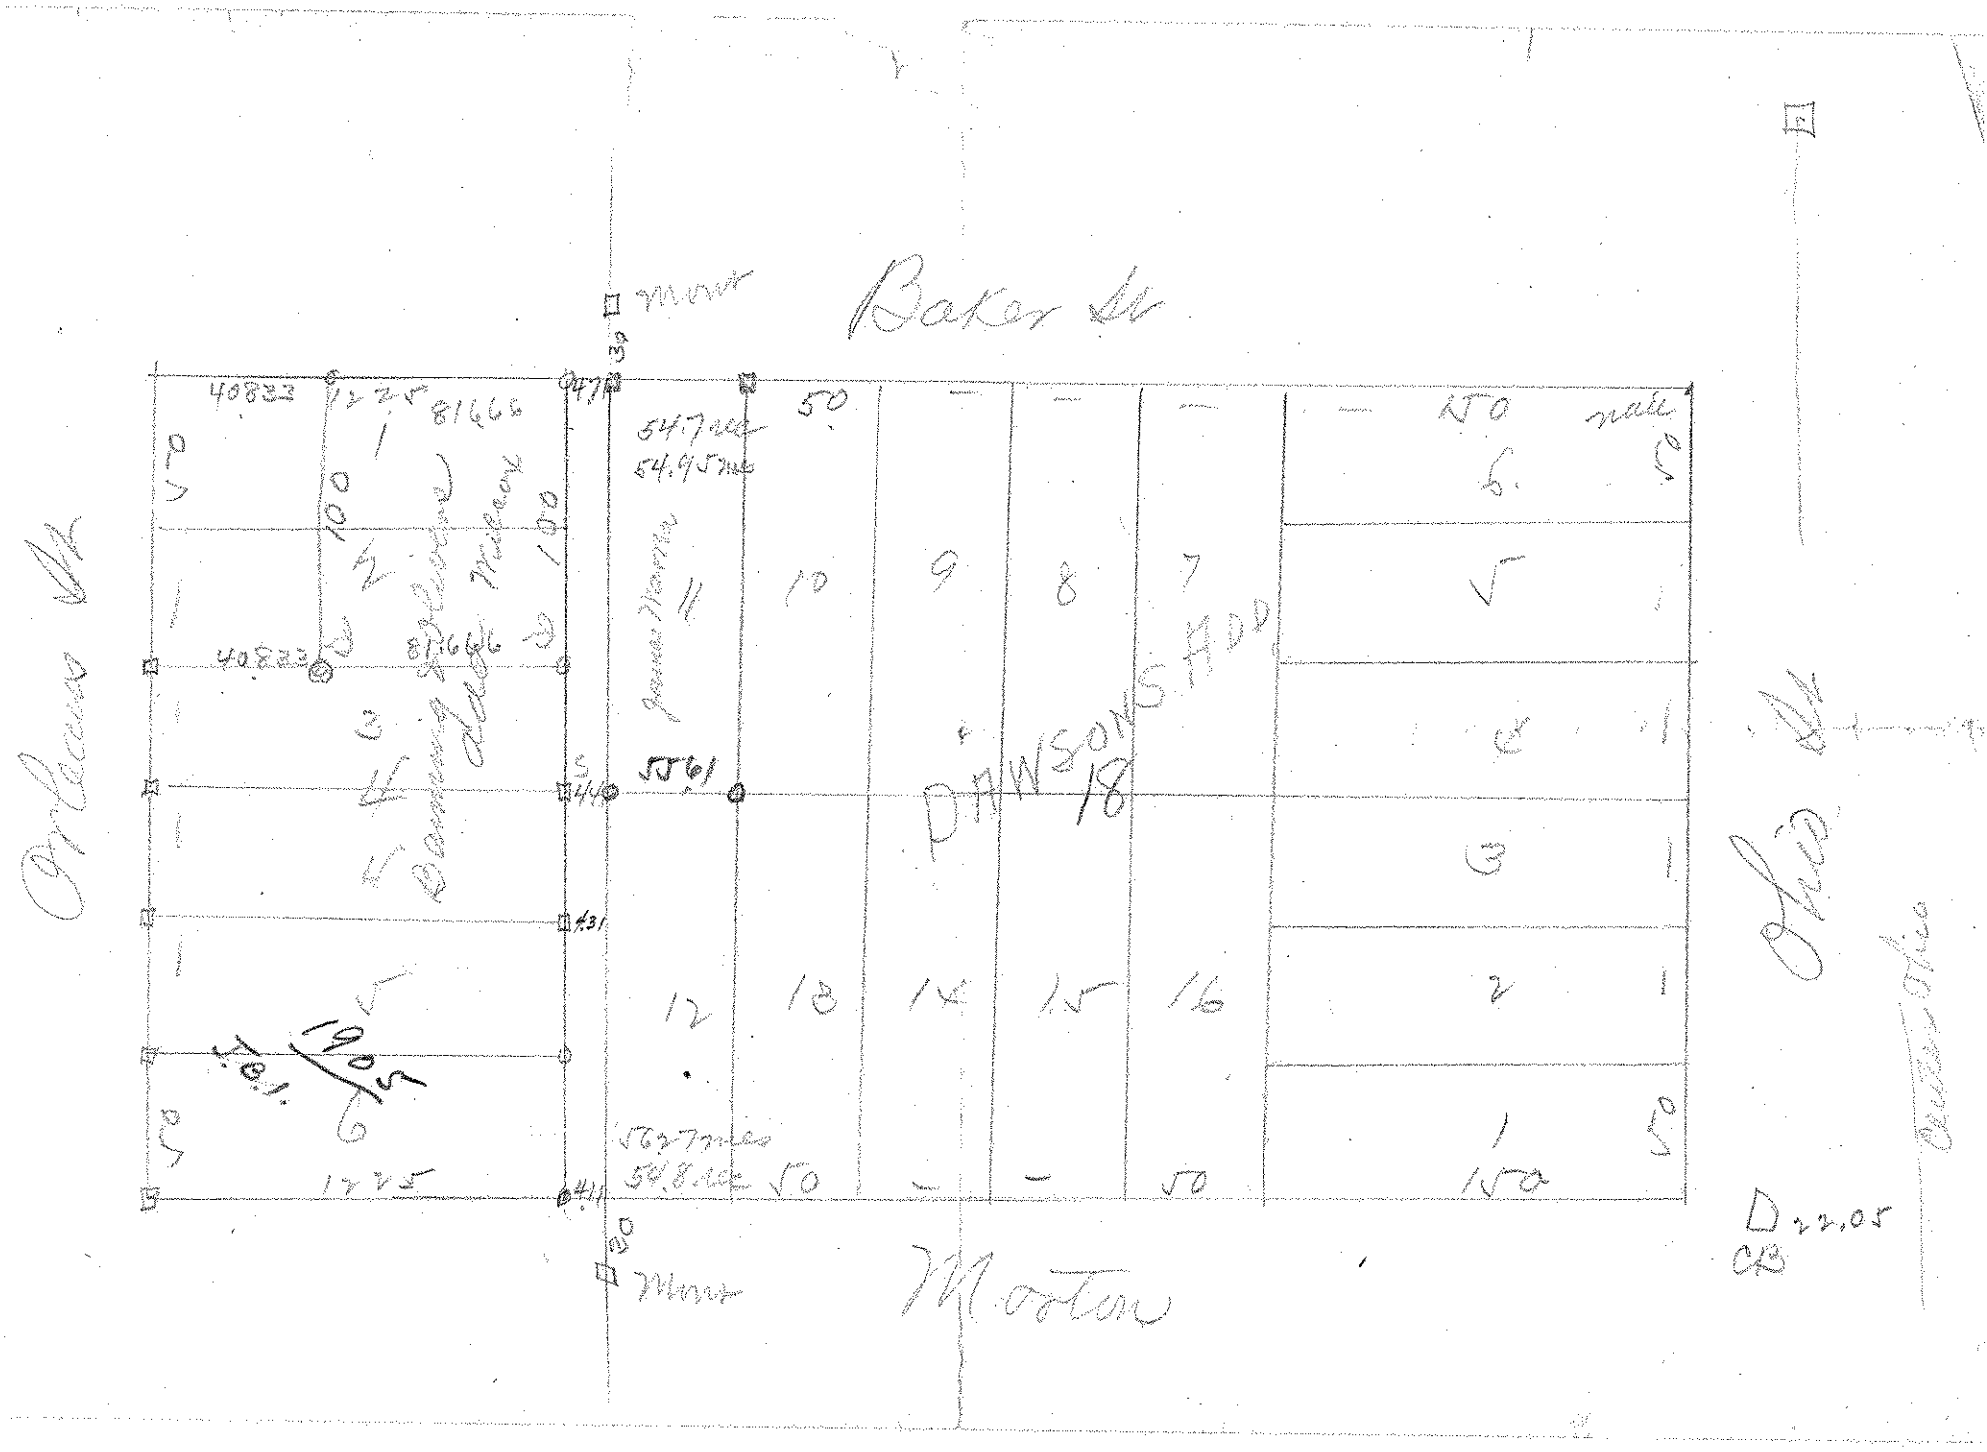
Baker St
Morton
Orleans St
Ohio St
DAWSONS ADD
18
Bandman Addition
McBride
Jessie Morris
40823
12.25
81666
54.7 acs
54.95 acs
50
50
6
5
4
3
2
1
10
9
8
7
11
12
13
14
15
16
5561
562.7 acs
54.8 acs
D 22.05