



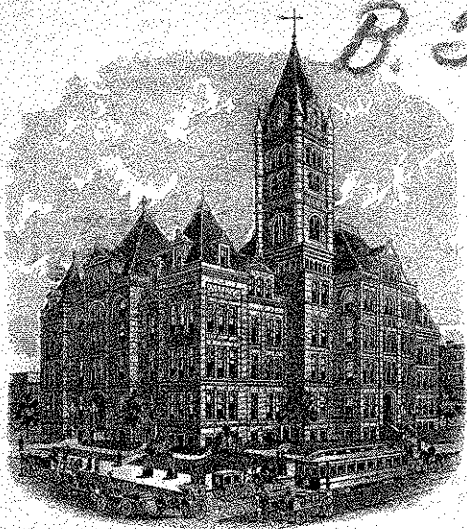

RAMSEY COUNTY COURT HOUSE

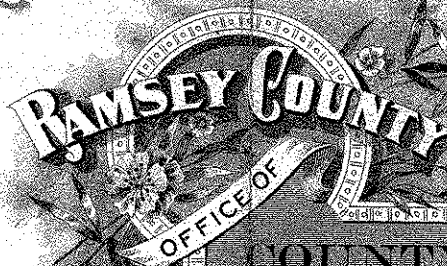

SW 28 22

JOHN B. IRVINE,
COUNTY SURVEYOR

408 GLOBE BLDG.,
4TH & CEDAR STS.

COUNTY SURVEYOR

St. Paul, Minn.

*Lot 5 Blk 56
Lawton Bros add.
B+O 7. E.O. Ingalls
Nov. - 13 - 1909.*