

N.W. Phone Office, Cedar 1779
Res., Dale 783

Lots Surveyed
Lands Subdivided
Leveling and Street Grades
Estimates Made
Drafting and Blue Printing
Surveys for Law Suits
Drainage Surveys
Topographical Surveys



JOHN B. IRVINE

CIVIL ENGINEER AND SURVEYOR


ROOM 408 GLOBE BUILDING

COR. FOURTH AND CEDAR STS.

ST. PAUL, MINN.

37.65 SW 28 22
lots 1-2-3 Blk 62
705 Chapin
Geo. Clark
191

Lot 9 Blk 59
Banning & Oliver's Add.
Josephine Rusch
443 Page 11
April 28-1913

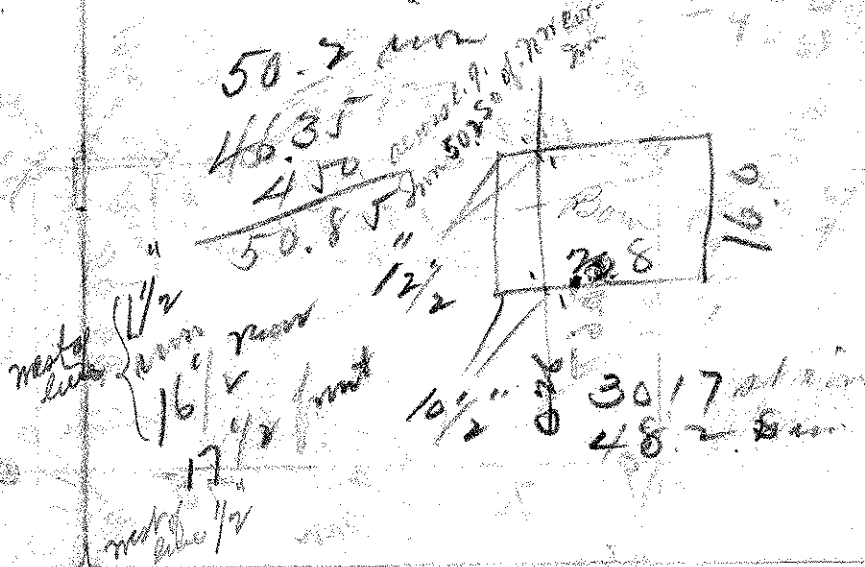

7.0
8.4

88
5.4
5.4