

NE 6 28 22

FROM THE OFFICE OF

CHARLES O. GEORGI COMPANY

2215 West County Road B

Saint Paul 8, Minnesota

REGISTERED CIVIL ENGINEER AND LAND SURVEYOR

Certificate of Survey

DEVACK WINDOW CO.

I Hereby Certify that this plat shows a building location survey made by me on the property ~~described on this plat~~^{shown}, and that all locations, have been correctly shown.

Date.....February 19, 1960


Scale 1" = 50'

By

REGISTERED LAND SURVEYOR

Description:

Setback of Building from Southerly
Line of Block 11, City of ST. PAUL BAZIL & GUERIN
is shown as requested.

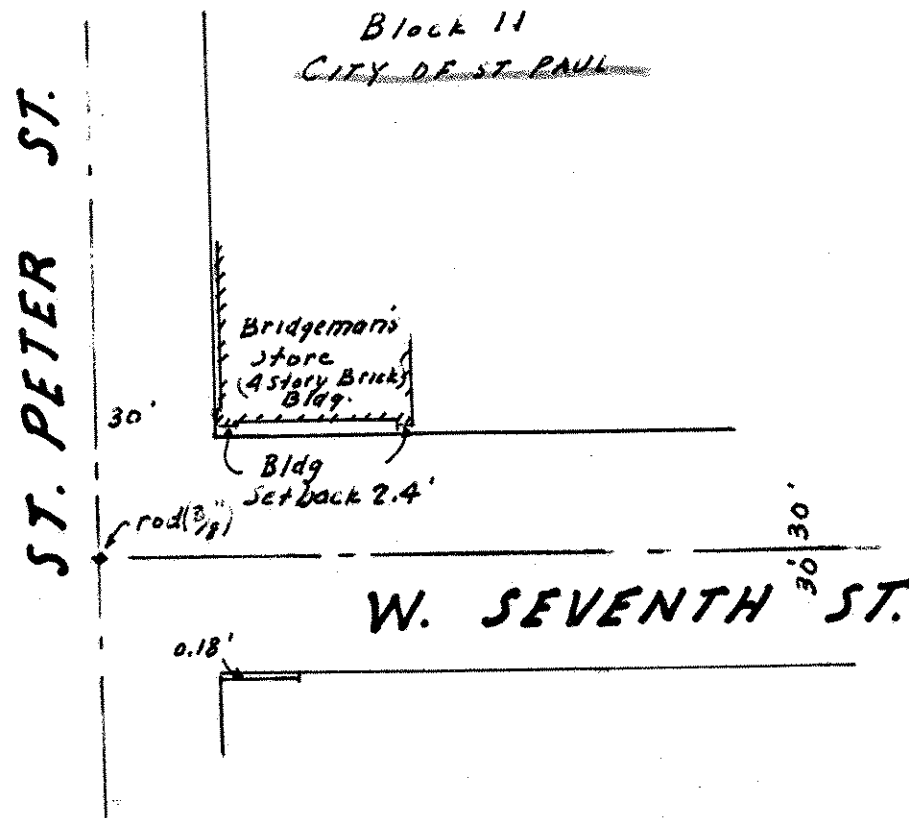

Note:

City Survey notes were checked
to verify the above setback.