

COMSTOCK AND DAVIS INC.

Surveyed for Sue Schnarr


Description:

Lot 5 and that part of Lot 6 lying Southeasterly of a line described as beginning at a point on the North line of said Lot 5 distant 10.0 feet (arc measurement) West of the Northeast corner of said Lot 6, said line terminating at the Southeast corner of said Lot 6, all in Block 3, Lewiston Heights.

Ramsey County, Minnesota

SCALE: 1" = 50'

• Denotes Iron Pipe Found
o Denotes Iron Pipe Set

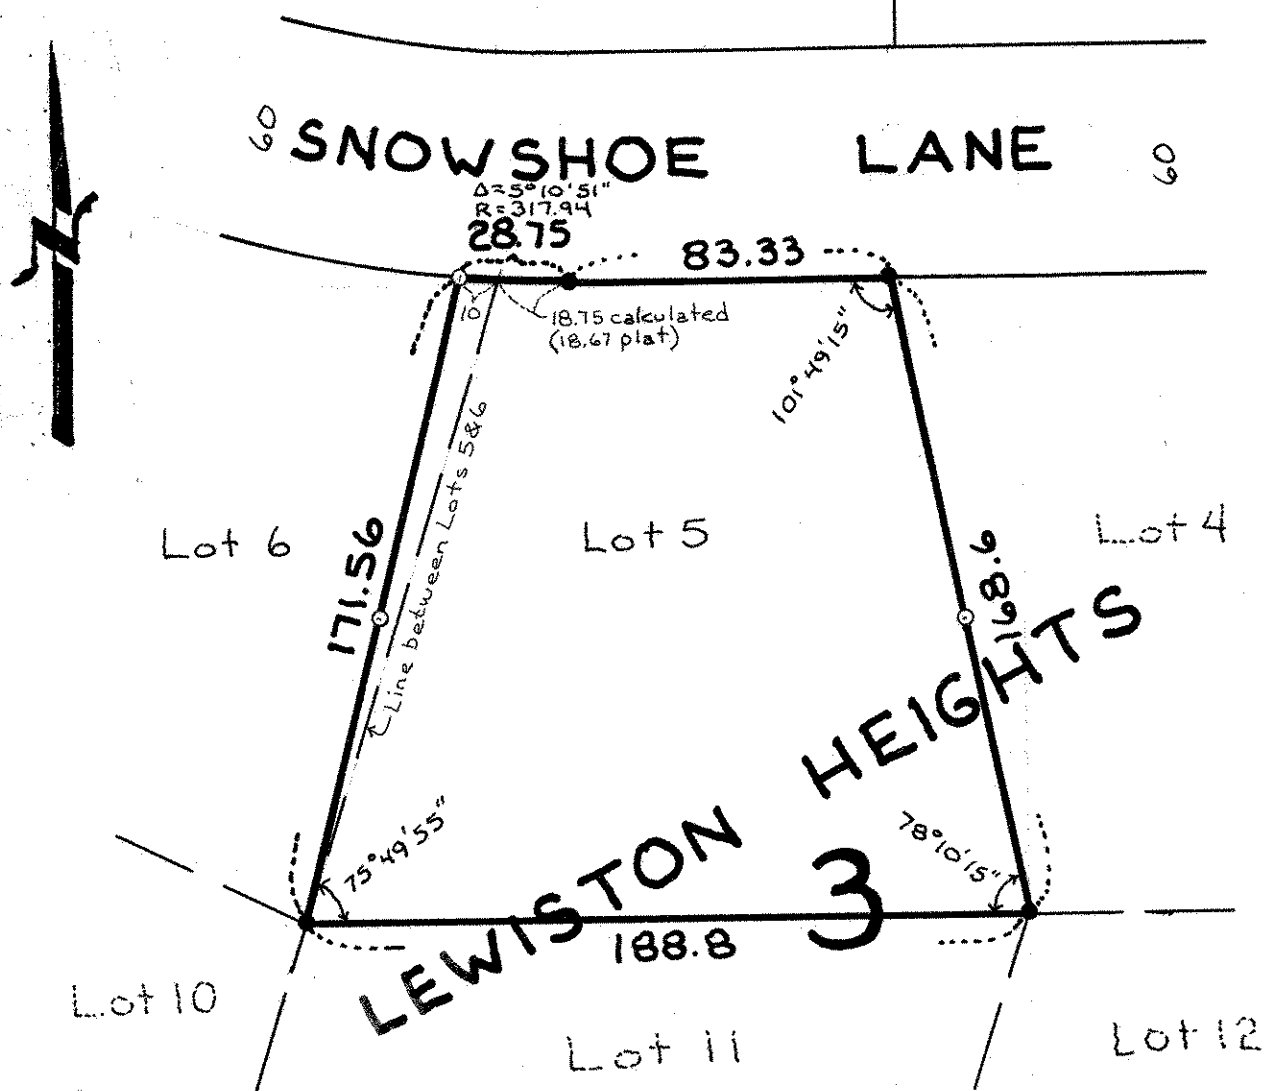

I hereby certify that this survey, plan plat, preliminary plat or report was prepared by me or under my direct supervision and that I am a duly Registered Land Surveyor under the laws of the State of Minnesota.

10459
Reg. No.

Date

R-91788
Job No.

Book No.

5/17/91