SE 14, 28, 22

FROM THE OFFICE OF

CHARLES O. GEORGI COMPANY

2215 West County Road B — Saint Paul 13, Minnesota

REGISTERED CIVIL ENGINEER AND LAND SURVEYOR

Certificate of Survey

I Hereby Certify that this plat shows a survey made by me of the property described on this plat, and that the corners are correctly placed as shown, and that all locations have been correctly shown.

Surveyed For Mr. French

Date January 1965

Scale 1" = 50'

Surveyor's Note: Road Easement has been relocated as shown.

By Charles O. Georgi
REGISTERED LAND SURVEYOR

Description:

All that part of Lots A and H, Registered Land Survey No. 47 filed in the office of Registrar of Titles in and for Ramsey County, Minnesota, lying Southwesterly of the following described line: beginning at a point on the Easterly line (being the centerline of McKnight Road) of said Lot H distant 21.4 feet South of the Northeast corner thereof, thence Northwesterly to the Northeast corner of said Lot A and there terminating. Also that part of Tract G which lies North of a line drawn between the mid-points on the Easterly and Westerly lines of Said Tract G.
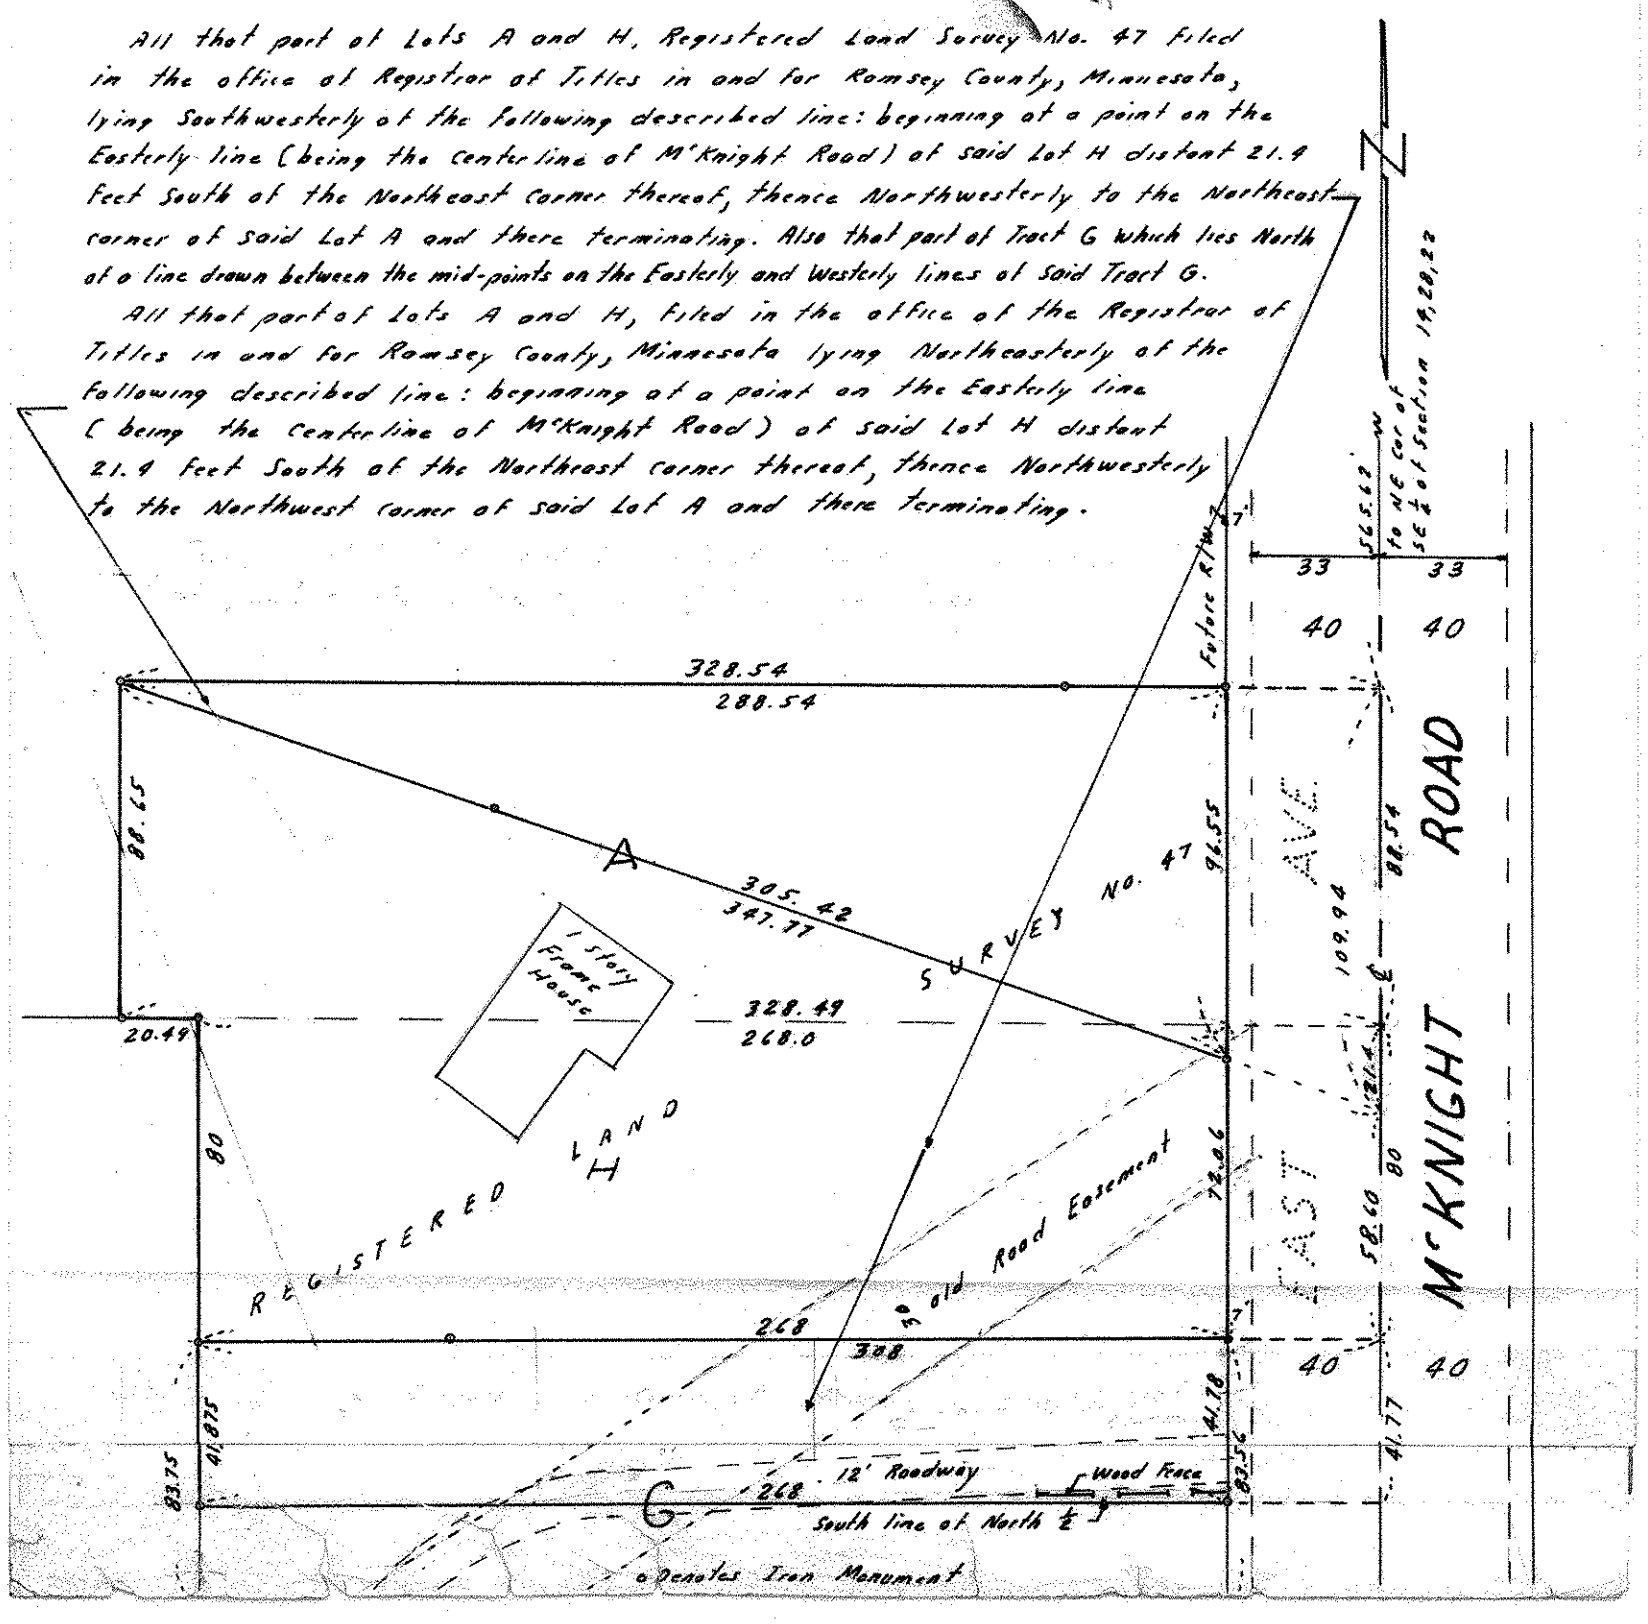
All that part of Lots A and H, filed in the office of the Registrar of Titles in and for Ramsey County, Minnesota lying Northeasterly of the following described line: beginning at a point on the Easterly line (being the centerline of McKnight Road) of said Lot H distant 21.4 feet South of the Northeast corner thereof, thence Northwesterly to the Northwest corner of said Lot A and there terminating.