

FROM THE OFFICE OF

CHARLES O. GEORGI COMPANY

2215 West County Road B

Saint Paul 13, Minnesota

REGISTERED CIVIL ENGINEER AND LAND SURVEYOR

**Certificate
of Survey**

I Hereby Certify that this plat shows a survey made by me of the property described on this plat, and that the corners are correctly placed as shown, and that all locations have been correctly shown.

Surveyed For *J.R. Walker - Adi Khambata*

Date..... *June 1963*


Scale..... *1" = 50'*

By

Charles O. Georgi
REGISTERED LAND SURVEYOR

Description:

The South 40 feet of Lot 4 and the North 50 feet of Lot 5, Block 3, South Battle Creek Heights.

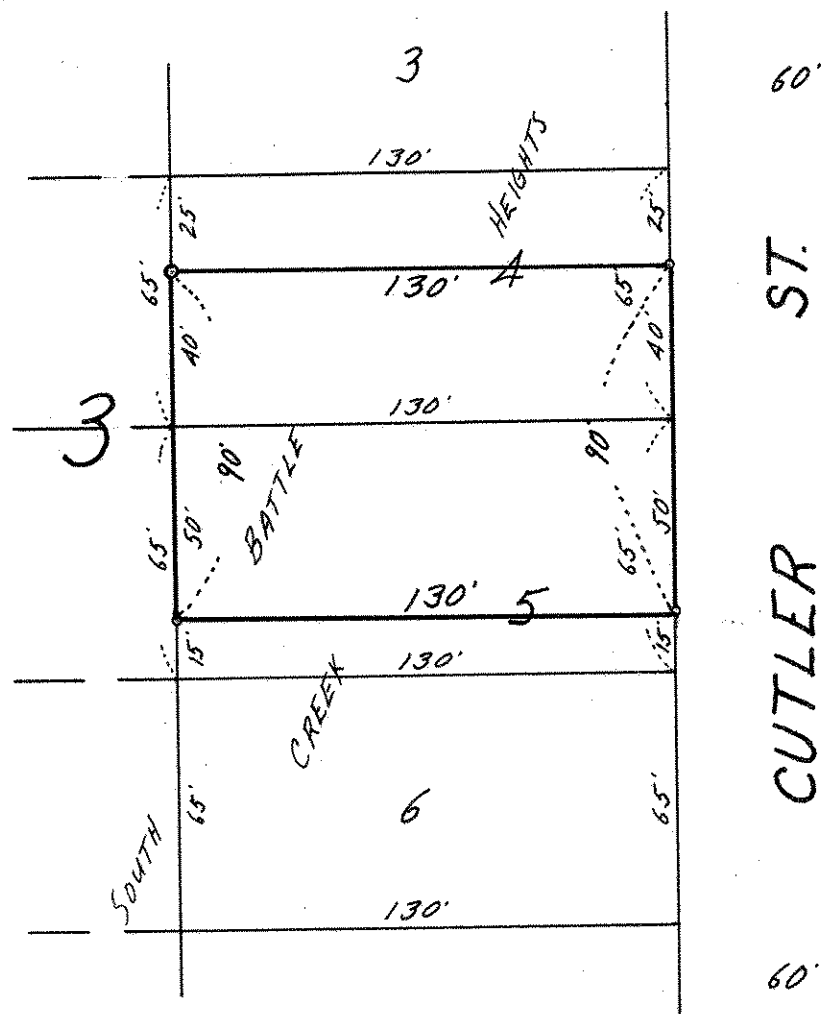

◦ Denotes Iron Monument