

Certificate of Survey

From the office of GEORGI-SCHMIDT & ASSOC. INC.

3092 No. Lexington Ave., Roseville, Mn. 55113


LAND SURVEYING

483-4408

I Hereby Certify that this plat shows a survey made by me of the property described on this plat, and that the corners are correctly placed as shown, and that all locations have been correctly shown.


Job Number: 367Surveyed For Clarence WalkerDate June 20, 1979Scale 1" = 40'

By

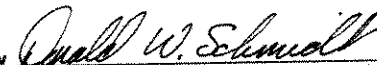
 REGISTERED LAND SURVEYOR

Description:


Lot 14 except the West 1/2 and Lot 15,
Lawton's Rearrangement of Block 15 of Woodbury & Case's Addition,
Ramsey County, Mn.

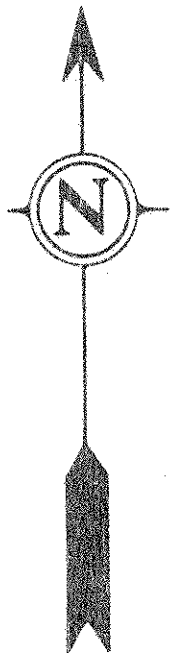

o Denotes Iron Pipe Monument

60
MT. HOPE AVENUE

60

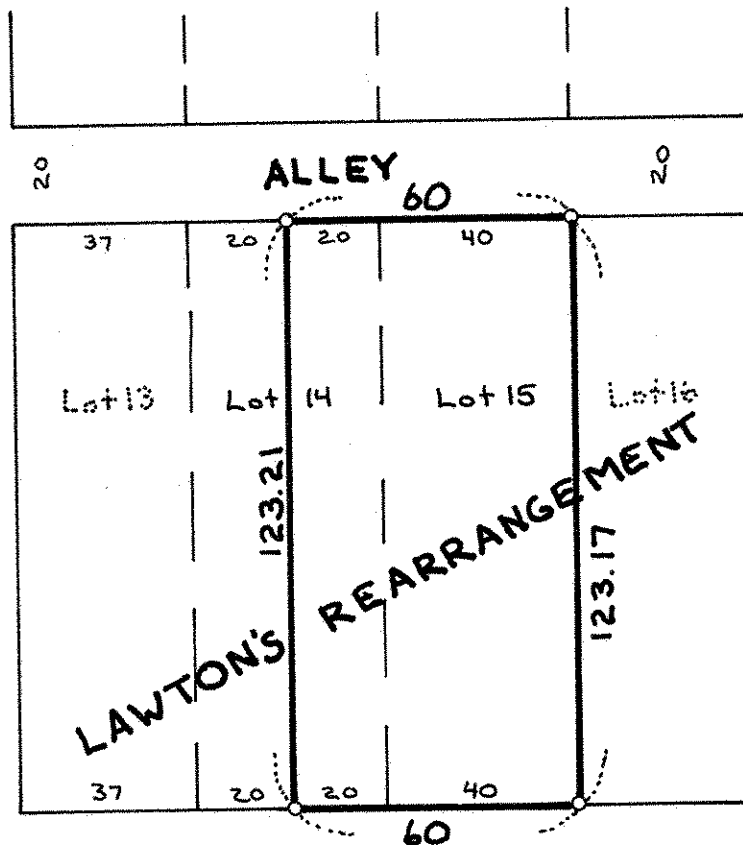

60

E. PAGE STREET 60