

FROM THE OFFICE OF

**CHARLES O. GEORGI COMPANY**

2215 West County Road B

Saint Paul, Minnesota 55113

REGISTERED CIVIL ENGINEER AND LAND SURVEYOR

# Certificate of Survey

I Hereby Certify that this plat shows a survey made by me of the property described on this plat, and that the corners are correctly placed as shown, and that all locations have been correctly shown.

Surveyed For *Water Dept.*


Date *Oct 1968*

Scale *1" = 100'*

By *Charles O. Georgi*  
REGISTERED LAND SURVEYOR

## Description:

*The North 200 feet of the South 900 feet of the West 550 feet  
of the SW  $\frac{1}{4}$  of SW  $\frac{1}{4}$  of Section 12, T28N, R22W.  
Subject to McKnight Road.*

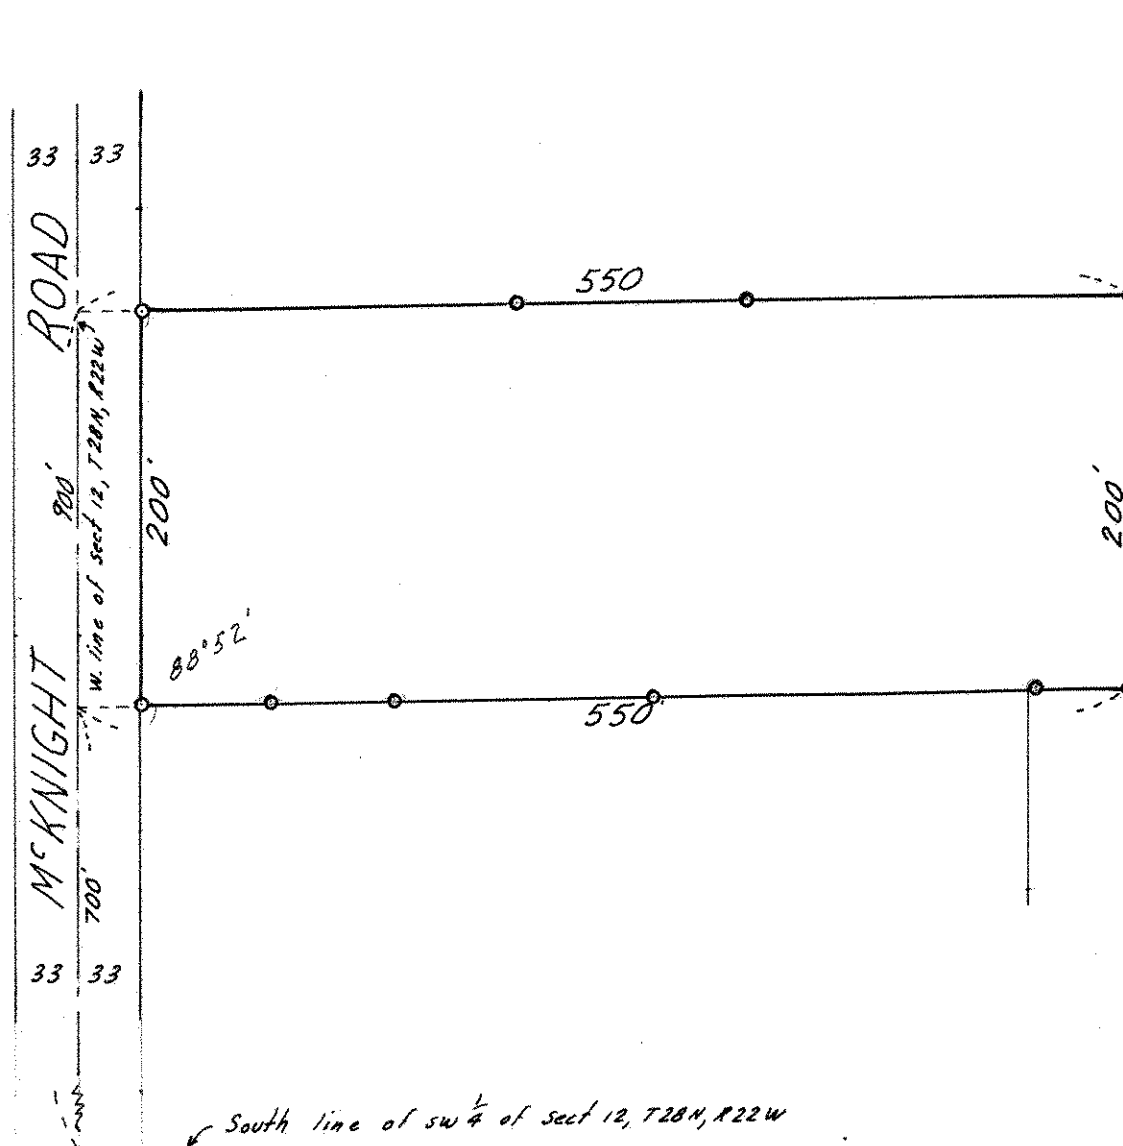

○ Denotes Iron Monument