

NE 2, 28, 22

FROM THE OFFICE OF

CHARLES O. GEORGI COMPANY

2215 West County Road B

Saint Paul 13, Minnesota

REGISTERED CIVIL ENGINEER AND LAND SURVEYOR

Certificate of Survey

I Hereby Certify that this plat shows a survey made by me of the property described on this plat, and that the corners are correctly placed as shown, and that all locations have been correctly shown.

Surveyed For *Joseph D. Woodward*

Date *August 1965*

Scale *1" = 50'*

By

Charles O. Georgi
REGISTERED LAND SURVEYOR

Description:


Lot 21

Block 1

South Bottle Creek Heights



60
ST.
NELSON
60

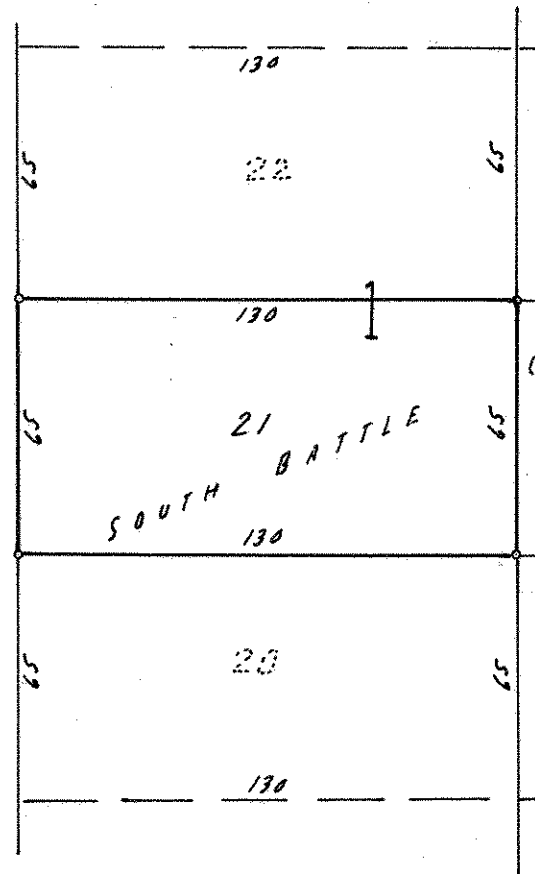

• Denotes Iron Monument