

Certificate of Survey

From the office of GEORGI-SCHMIDT & ASSOC. INC.

3092 No. Lexington Ave., Roseville, Mn. 55113

LAND SURVEYING

483-4408

I Hereby Certify that this plat shows a survey made by me of the property described on this plat, and that the corners are correctly placed as shown, and that all locations have been correctly shown.

Job Number: 115

C.D. District 9

Parcel 1-G

Area: 7288 Sq. Ft., m.o.L.


Surveyed For Housing AuthorityDate September 1978Scale 1"=50'By Donald W. Schmidt
REGISTERED LAND SURVEYOR

Description:

That part of Lots 6 and 7, described as follows; * Commencing at the SE corner of Lot 5; thence $N102^{\circ}06'06''W$ (assumed bearing) 127.26 feet along the Easterly line of said Lots 5, 6, and 7 to the point of beginning; thence $S102^{\circ}06'06''E$ 40.0 feet along the said Easterly line of Lots 5, 6, and 7; thence $N89^{\circ}48'41''W$ 40.0 feet; thence $S66^{\circ}12'45''W$ 36.92 feet; thence $N89^{\circ}48'41''W$ 75.0 feet to the Westerly line of said Lot 6; thence $N02^{\circ}25'09''W$ 55.0 feet along the Westerly line of said Lots 6 and 7; thence $S89^{\circ}48'41''E$ 148.24 feet to the point of beginning; which is within the property described in certificate No. 212294, Block 35, Rice and Irvine's Addition to St. Paul. (Registered Property)

And that part of Lots 6 and 7, described as follows; * commencing (see above), except that part of the property described in Certificate No. 212294, Block 35, Rice and Irvine's Addition to St. Paul, (Abstract Property) 66

Ramsey County, Minn.

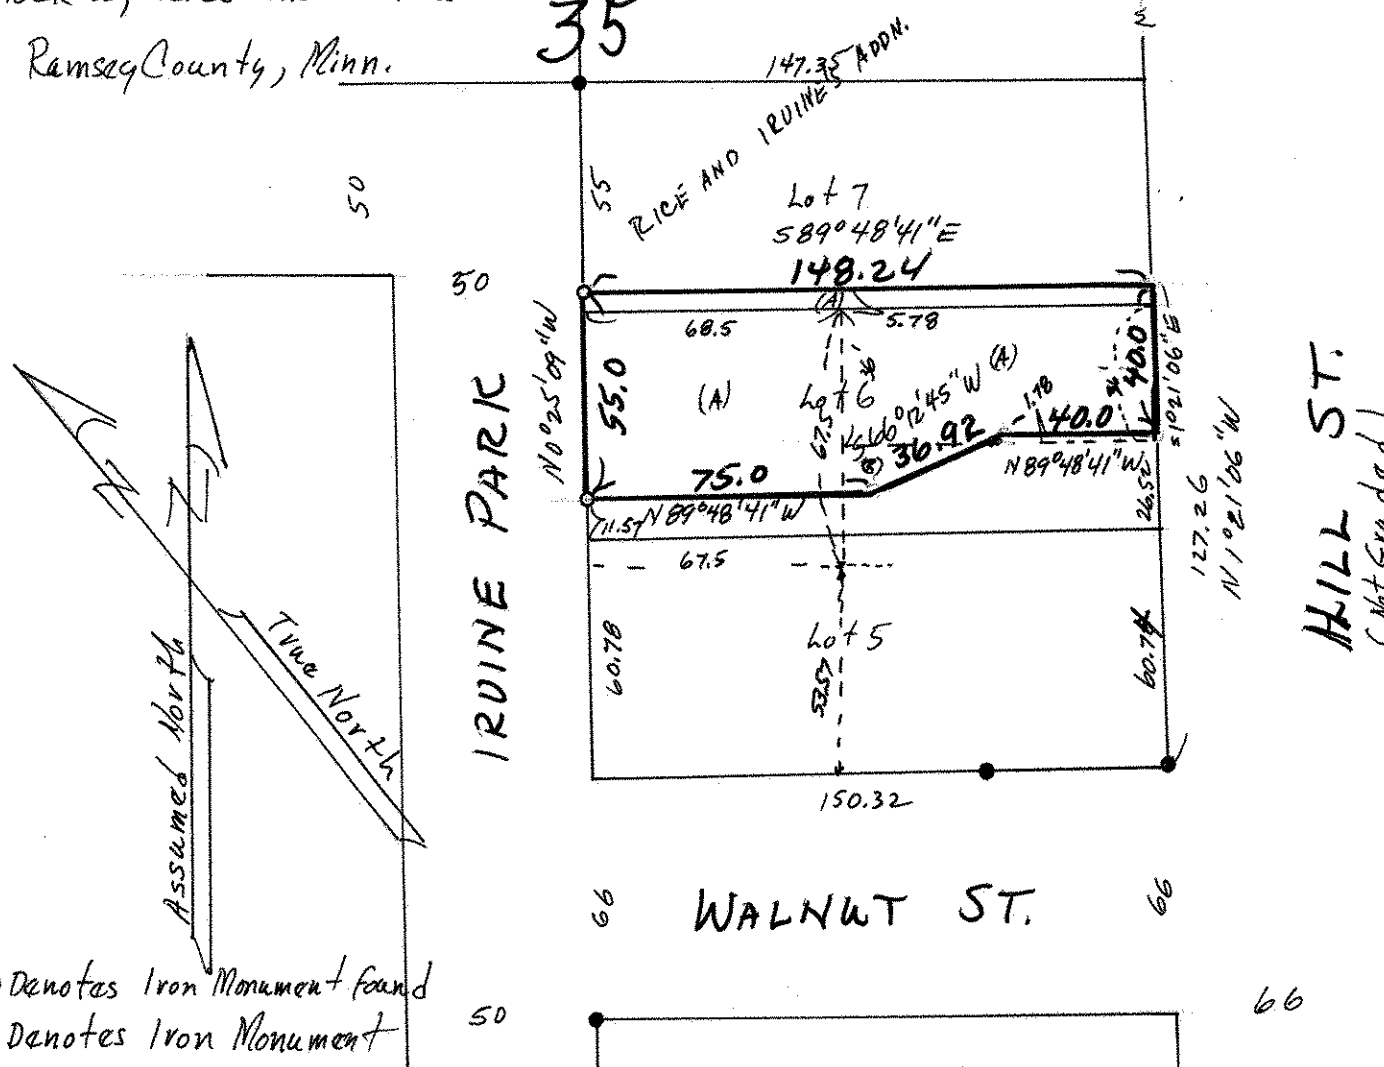

● Denotes Iron Monument found
○ Denotes Iron Monument