BLOCK 13

BAZILLE & ROBERTS ADD.

TO

WEST ST. PAUL.

JOHN B. IRVINE, SURVEYOR.

APRIL 27-1910.
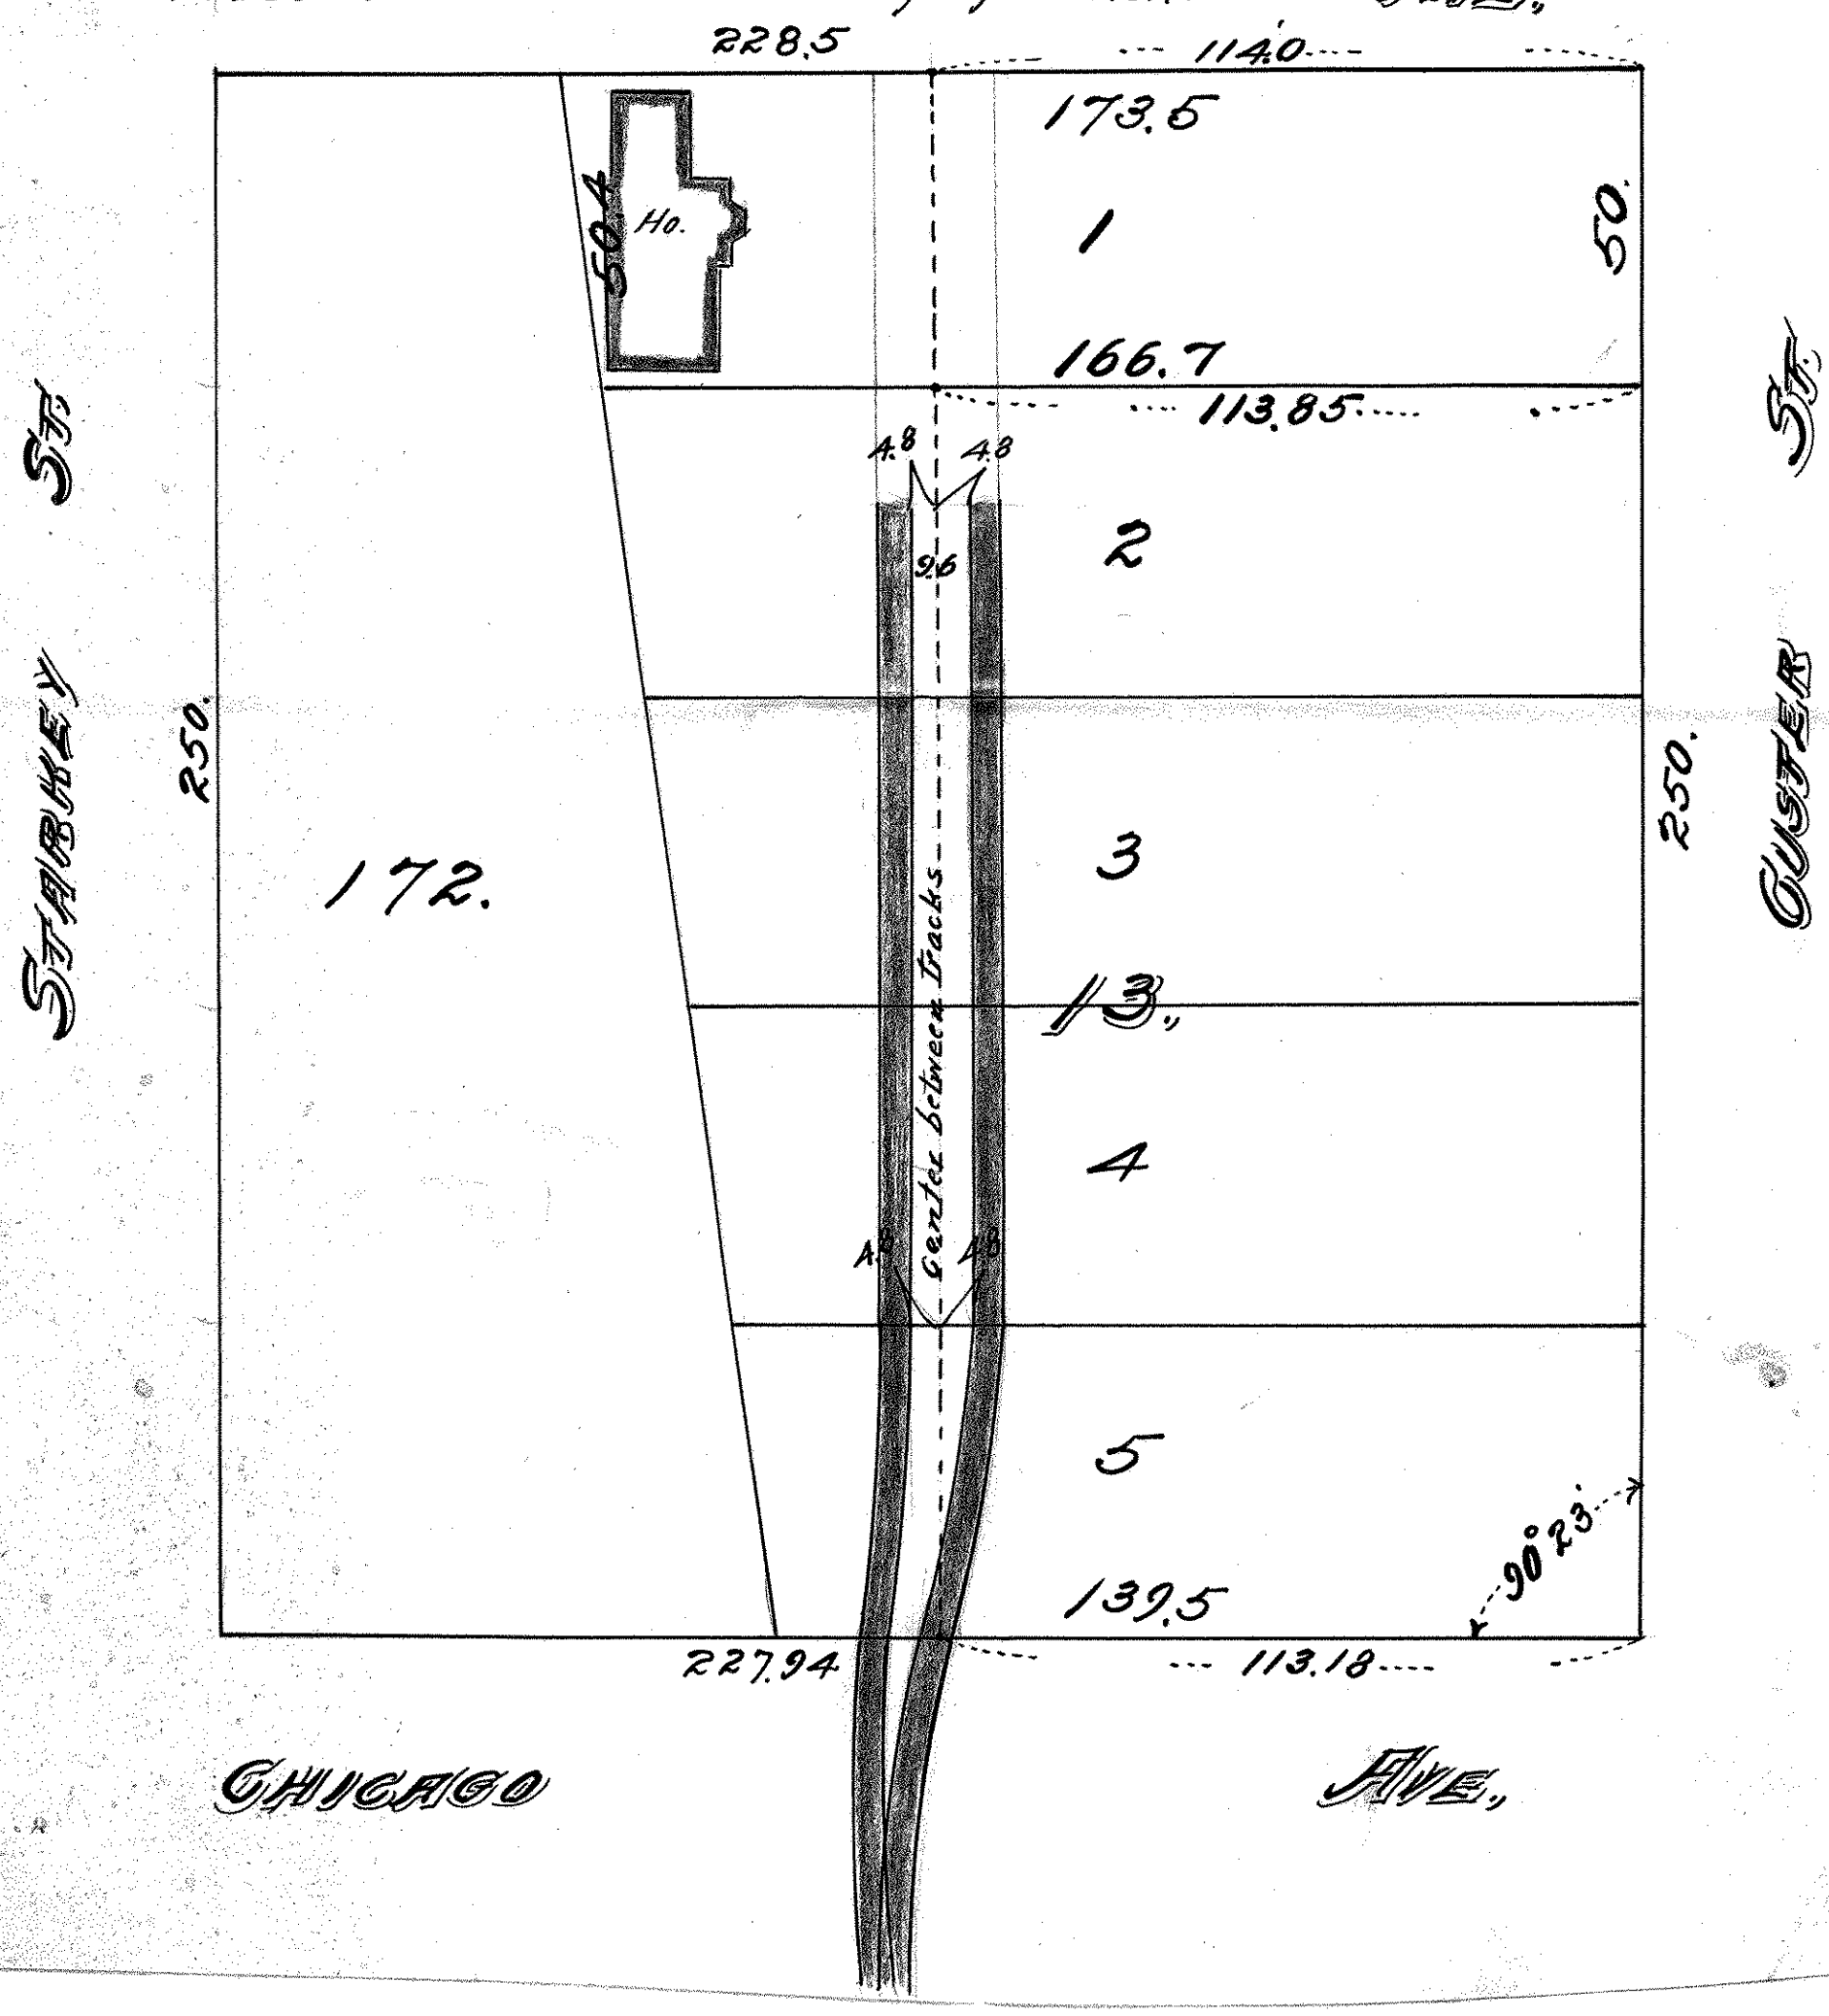
SCALE 30 ft. per inch.