


I hereby certify that this diagram correctly represents the Easterly 40 ft. of lots 1 & 2 Block 9 Bazille & Roberts. Dated as surveyed by me this day.

John B. Irvine.
County Surveyor.
Room 16 Court House.

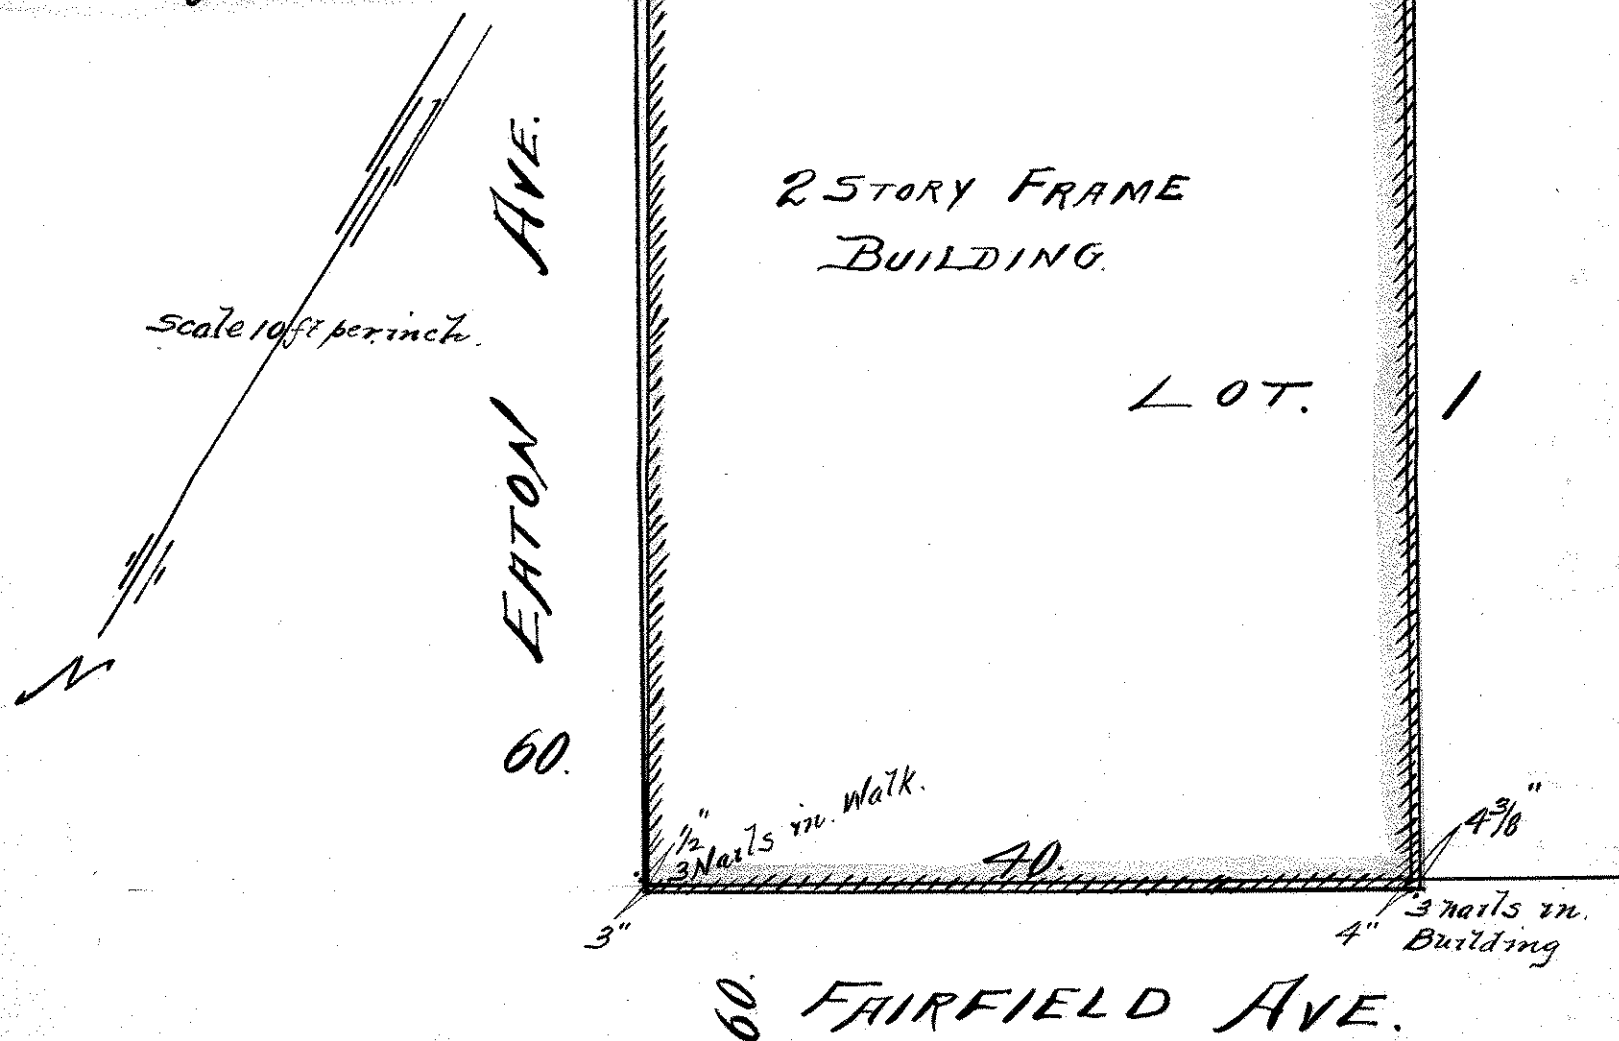

B47. P. 66.