

FROM THE OFFICE OF

CHARLES O. GEORGI COMPANY

2215 West County Road B

Saint Paul 13, Minnesota

REGISTERED CIVIL ENGINEER AND LAND SURVEYOR

Certificate of Survey

I Hereby Certify that this plat shows a survey made by me of the property described on this plat, and that the corners are correctly placed as shown, and that all locations have been correctly shown.

Surveyed For..... *Richard Henninger*


Date..... August 1965

Scale..... 1" = 50'

By Charles O. George
REGISTERED LAND SURVEYOR

Description:

Lot 23
Block 1
South Battle Creek Heights

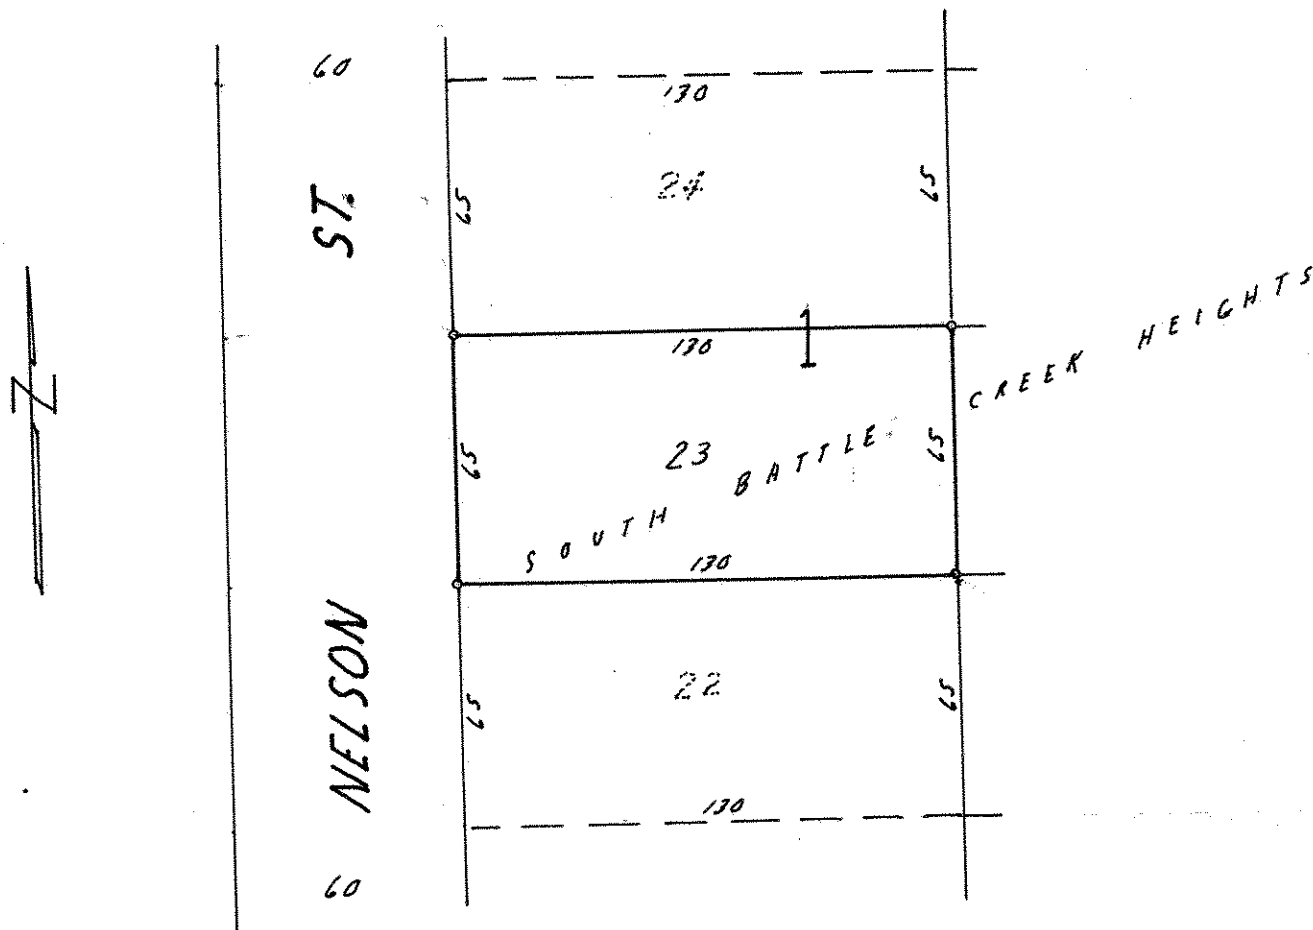

o Denotes Iron Monument