


27.

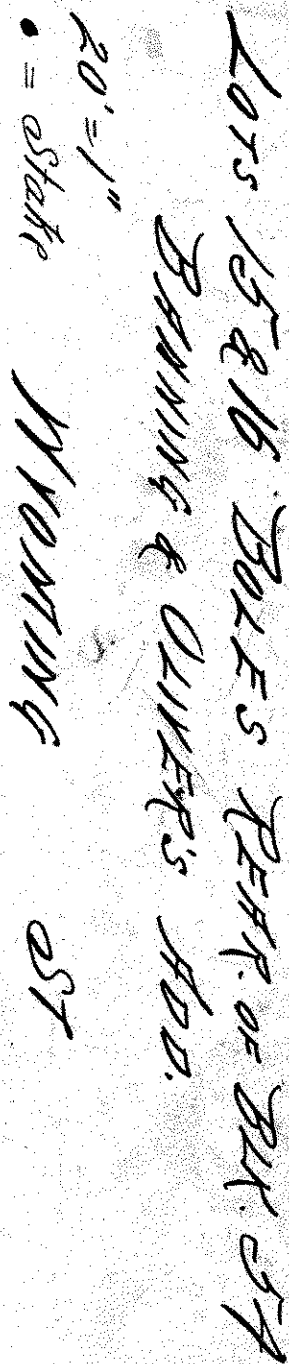

H. H. Jensen. Aug. 1904.

2 sty. Brk. Bldg.

~~25/11/5~~

11/15/95