

PART OF LOT 13.
BIDWELL'S ADD.

TO WEST ST. PAUL, PROPER.

John B. Irvine, Surveyor.

St Paul, Minn.


Oct. 24-1919.

Scale
40 ft. per inch.

The north 50 ft. of that part of lot 13 Bidwells Add. to West St. Paul, Proper lying east of the easterly line of lots 2 & 3 Block 153 West St Paul Proper and between the north line of said lot 2 and the south line of said lot 3 Block 153 West St. Paul, Proper, produced easterly to the westerly line of ^{south} Robert St.

CURTICE

S.F.

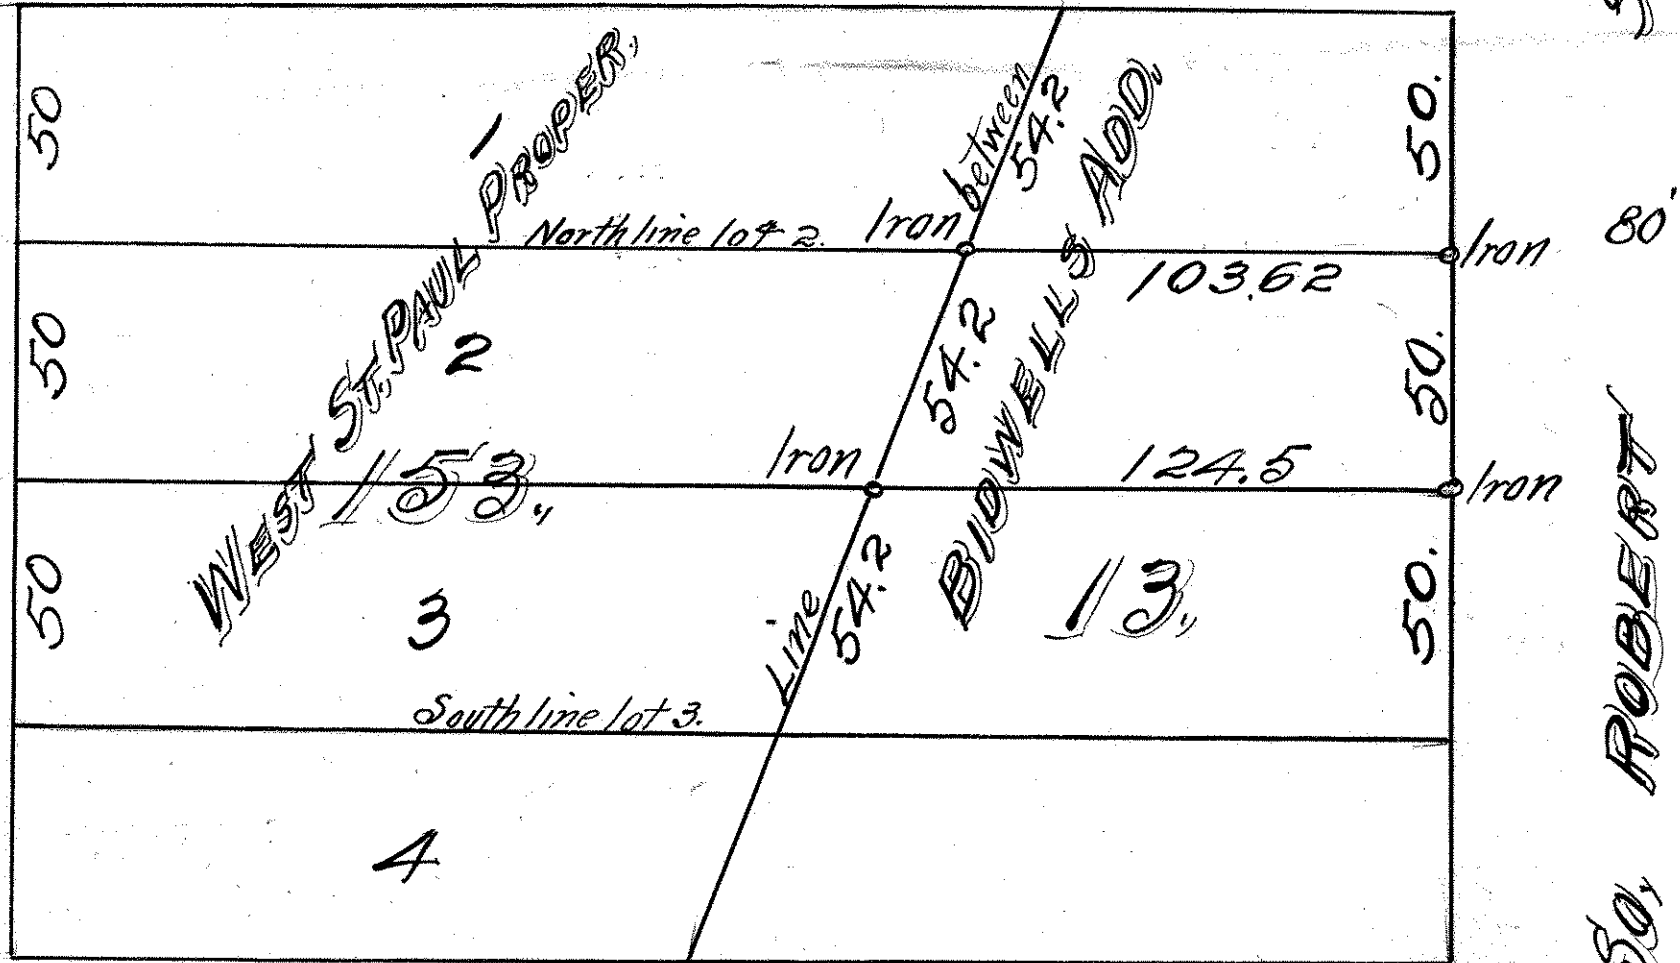

BELVIDERE

S.F.