

FROM THE OFFICE OF

CHARLES O. GEORGI COMPANY

2215 West County Road B

Saint Paul, Minnesota 55113

REGISTERED CIVIL ENGINEER AND LAND SURVEYOR

Certificate of Survey

I Hereby Certify that this plat shows a survey made by me of the property described on this plat, and that the corners are correctly placed as shown, and that all locations have been correctly shown.


Footbridge between Young Quinlan &
Dayton's across Wabasha St.

Surveyed For..... *Housing Authority*

Date July 1976

Scale 1" = 20

By Charles O. Longi
REGISTERED LAND SURVEYOR

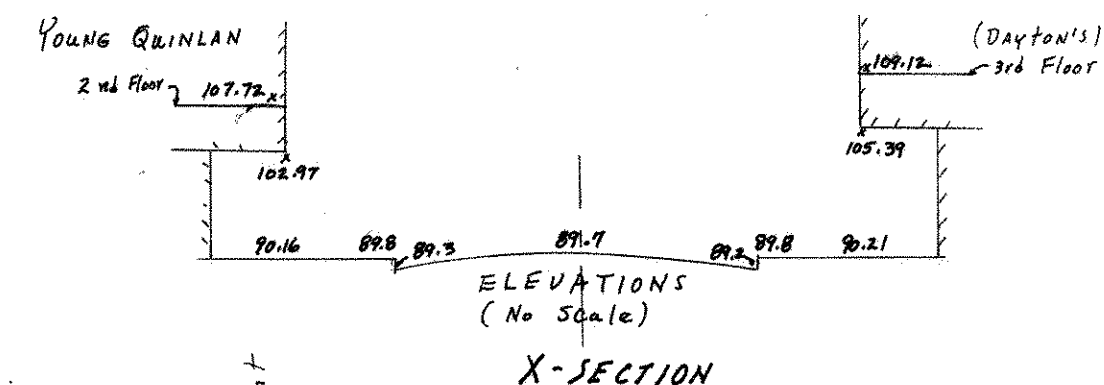

B.M. = 93.75 = Top Hydrant SE Cor. 6th & Wabasha
(City of St. Paul Datum)

