

FROM THE OFFICE OF

CHARLES O. GEORGI COMPANY

2215 West County Road B

Saint Paul 13, Minnesota

REGISTERED CIVIL ENGINEER AND LAND SURVEYOR

Certificate
of Survey

I Hereby Certify that this plat shows a survey made by me of the property described on this plat, and that the corners are correctly placed as shown, and that all locations have been correctly shown.

Surveyed For **DONNAY-REITZ INC.**

Date..... **August 1960**

Scale $1"=100'$

By Charles C. George
REGISTERED LAND SURVEYOR


Description:

Lot

Block 2

AFTON HEIGHTS ADDITION

UPPER AFTON ROAD

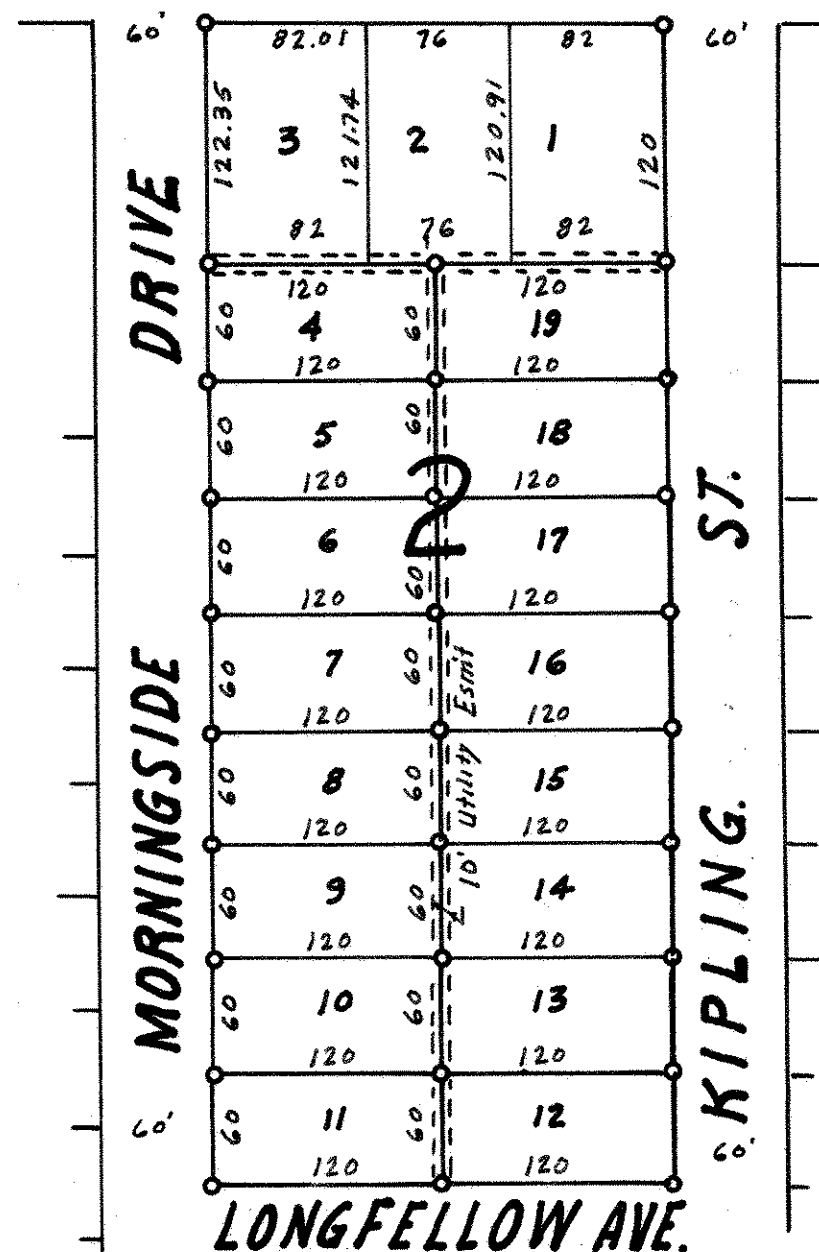

• Denotes Iron Monument