

FROM THE OFFICE OF

CHARLES O. GEORGI COMPANY

2215 West County Road B

Saint Paul 8, Minnesota

REGISTERED CIVIL ENGINEER AND LAND SURVEYOR

**Certificate
of Survey**

I Hereby Certify that this plat shows a building location survey made by me on the property described on this plat, and that all locations, have been correctly shown.

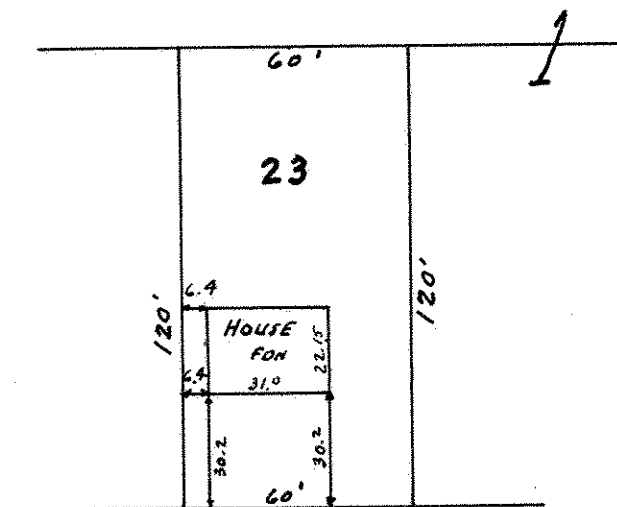
DONNAY-REITZ INC.

Date *February 1961*Scale 1" = *50'*

By

Charles O. Georgi
REGISTERED LAND SURVEYOR

Description:

*Lot 23**Block 1**Afton Heights Addition*

DELLRIDGE

60'

AVE.