

FROM THE OFFICE OF

CHARLES O. GEORGI COMPANY

2215 West County Road B

Saint Paul 8, Minnesota

REGISTERED CIVIL ENGINEER AND LAND SURVEYOR

**Certificate
of Survey**


I Hereby Certify that this plat shows a building location survey made by me on the property described on this plat, and that all locations, have been correctly shown.

DONNAY-REITZ INC

Date *February 1941*Scale 1" = *50'*By *Charles O. Georgi*
REGISTERED LAND SURVEYOR

Description:

*Lot 22 and the East 5.0 feet of Lot 21
Block 1
Afton Heights Addition*

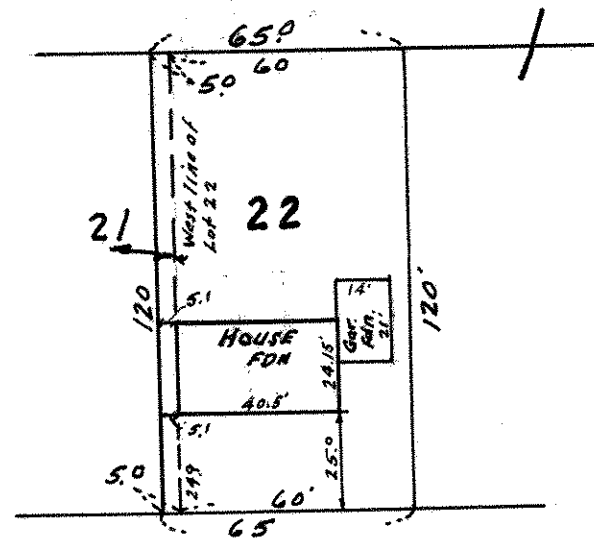

DELLRIDGE AVE.