

SC 2 28 22

FROM THE OFFICE OF

CHARLES O. GEORGI COMPANY

2215 West County Road B

Saint Paul 8, Minnesota

REGISTERED CIVIL ENGINEER AND LAND SURVEYOR

Certificate of Survey

I Hereby Certify that this plat shows a building location survey made by me on the property described on this plat, and that all locations, have been correctly shown.

Date OCTOBER 1960

Scale 1" = 50'


By Charles O. Georgi
REGISTERED LAND SURVEYOR

DONNAY - REITZ Inc.
Description:

Lot 13

Block 2

AFTON HEIGHTS ADDITION

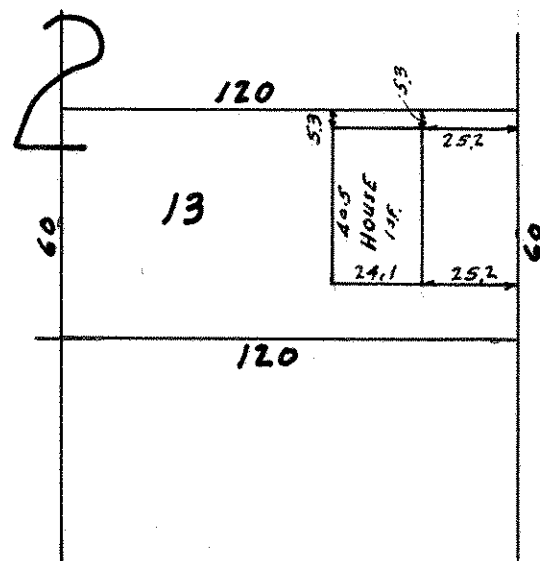

60' KIPLING ST

LONGFELLOW AVE