

FROM THE OFFICE OF

CHARLES O. GEORGI COMPANY

2215 West County Road B

Saint Paul 8, Minnesota

REGISTERED CIVIL ENGINEER AND LAND SURVEYOR

**Certificate
of Survey**

I Hereby Certify that this plat shows a building location survey made by me on the property described on this plat, and that all locations, have been correctly shown.

DONNAY-REITZ INC.


Date August 1940Scale 1" = 50'By Charles O. Georgi
REGISTERED LAND SURVEYOR

Description:

Lot 2
Block 2
AFTON HEIGHTS ADDITION

UPPER AFTON ROAD

80'

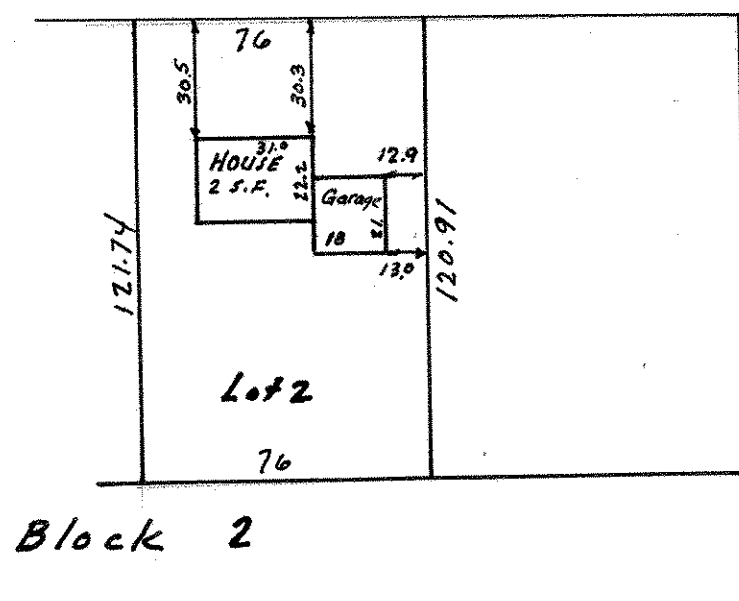

60'

KIPLING ST.

