

FROM THE OFFICE OF

# CHARLES O. GEORGI COMPANY

2215 West County Road B

Saint Paul 8, Minnesota

REGISTERED CIVIL ENGINEER AND LAND SURVEYOR

## Certificate of Survey

I Hereby Certify that this plat shows a building location survey made by me on the property described on this plat, and that all locations, have been correctly shown.

Date February 1961

Scale 1" = 50'

By Charles O. Georgi  
REGISTERED LAND SURVEYOR


DONNAY-REITZ INC.

Description:

Lot 29

Block 1

Afton Heights Addition

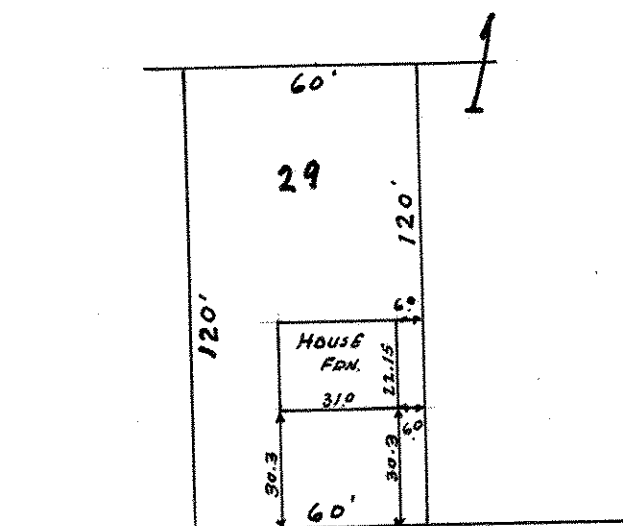

DELLRIDGE

60 AVE