

FROM THE OFFICE OF

CHARLES O. GEORGI COMPANY

2215 West County Road B

Saint Paul, Minnesota 55113

REGISTERED CIVIL ENGINEER AND LAND SURVEYOR

Certificate of Survey

I Hereby Certify that this plat shows a survey made by me of the property described on this plat, and that the corners are correctly placed as shown, and that all locations have been correctly shown.

Surveyed For Merton Christian


Date. November, 1970

Scale $1" = 40$

By Charles D. Long
REGISTERED LAND SURVEYOR

Description:

Lot 6, Block 11,
Nelson Stevens and King's Addition,
Ramsey County, Minnesota.

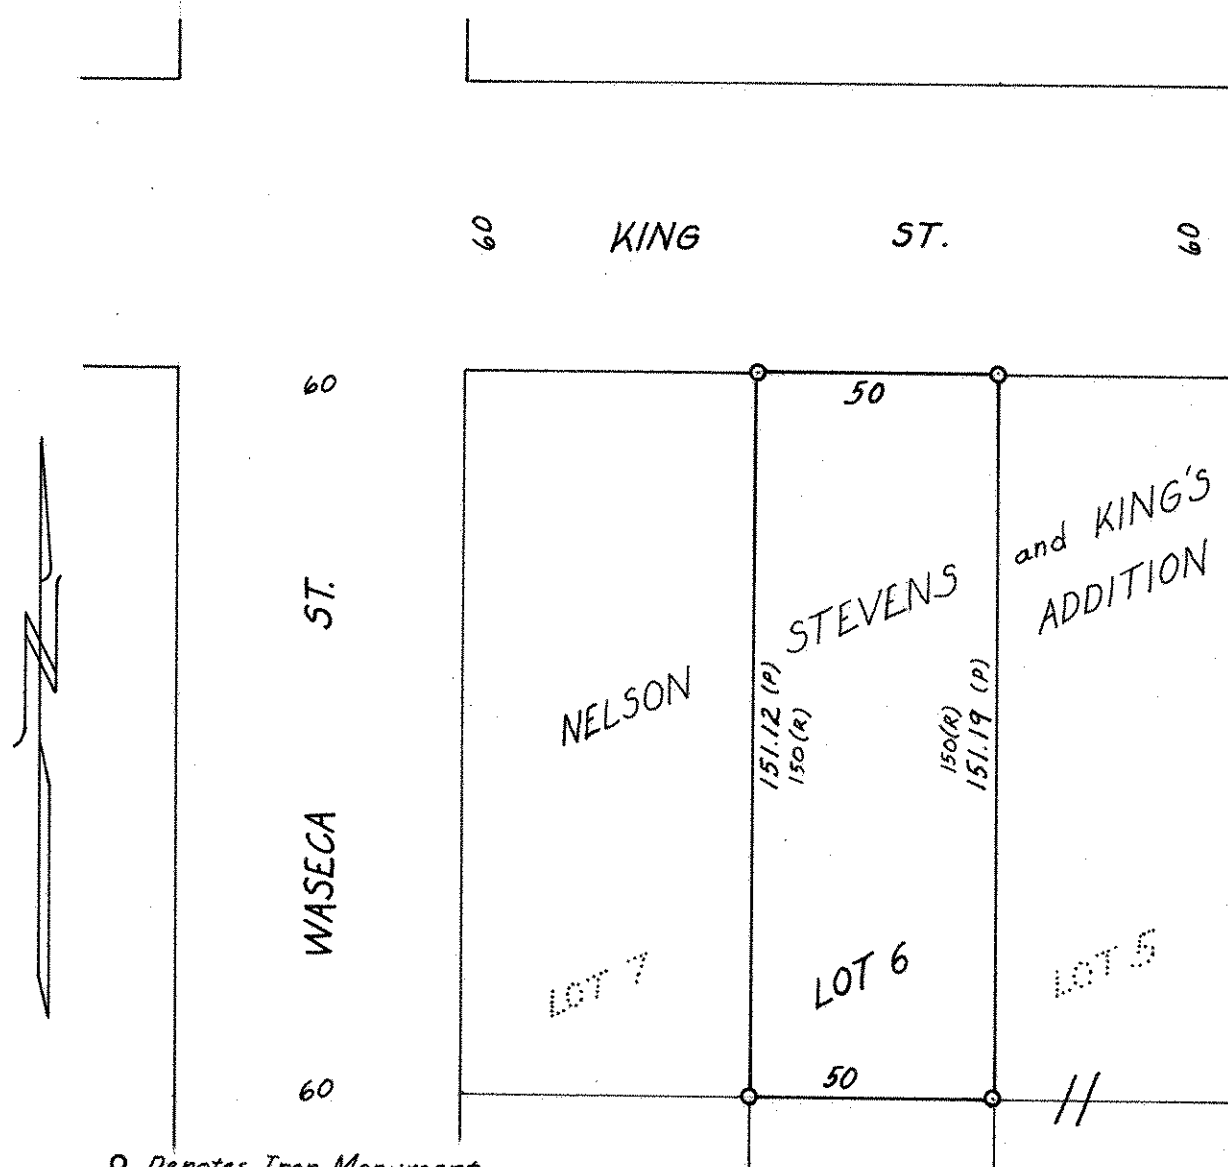

- Denotes Iron Monument
- (P) Denotes prorated distance
- (R) Denotes record distance