

FROM THE OFFICE OF

**CHARLES O. GEORGI COMPANY**

2215 West County Road B

Saint Paul 13, Minnesota

REGISTERED CIVIL ENGINEER AND LAND SURVEYOR

**Certificate  
of Survey**

I Hereby Certify that this plat shows a survey made by me of the property described on this plat, and that the corners are correctly placed as shown, and that all locations have been correctly shown.

Surveyed For M. BERLANDDate December 1959Scale 1" = 50'

## Description:

The West 82 feet of Lots 19 and 20  
Block 2  
AFTON HEIGHTS ADDITION


Description: By

*Charles O. Georgi*  
REGISTERED LAND SURVEYOR

The East 82 feet of Lots 1 and 2  
Block 2  
AFTON HEIGHTS ADDITION

N

North Line of SE 1/4  
Section 2, T28N, R22W

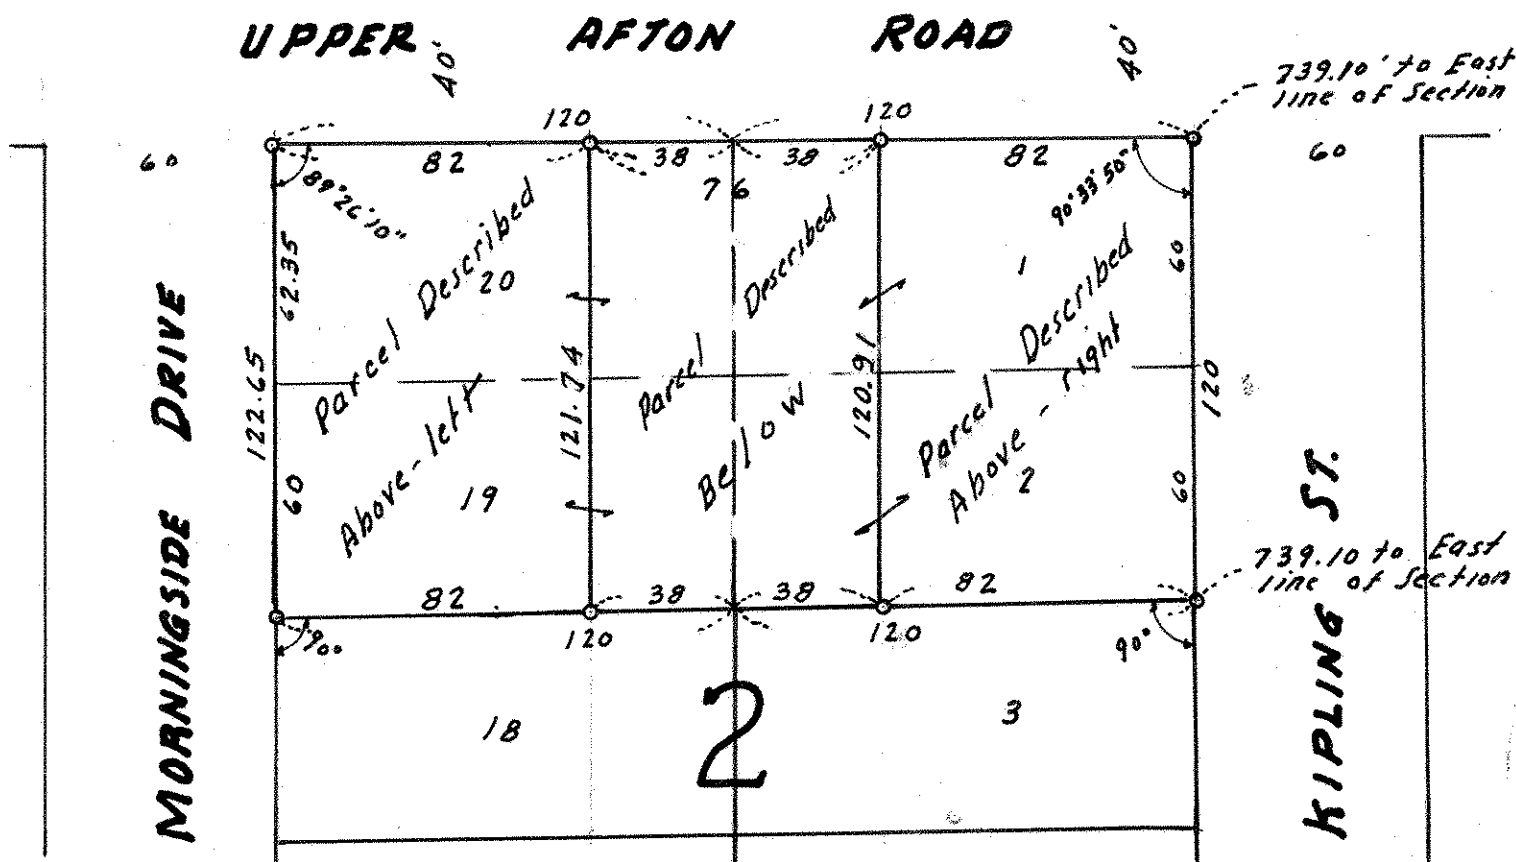

## Description:

Lots 19 and 20 except the West 82 feet thereof, and Lots 1 and 2 except the East 82 feet thereof; all in Block 2  
AFTON HEIGHTS ADDITION

Note: ○ Denotes Iron Monument  
Above Plat is an approved  
Preliminary Layout.