


TELEPHONE TOWER 0640

OF PROPERTY OF William J. Lynch
DESCRIBED AS FOLLOWS The East 1/2 of Lot 21 and the West 1/2 of Lot 22 Block 11
of Boulevard Addition
No 1435 Ashland Ave, St. Paul, Minn.

T. J. WELCH, REGISTERED SURVEYOR
738 SURREY AVENUE, ST. PAUL 6, MINN.

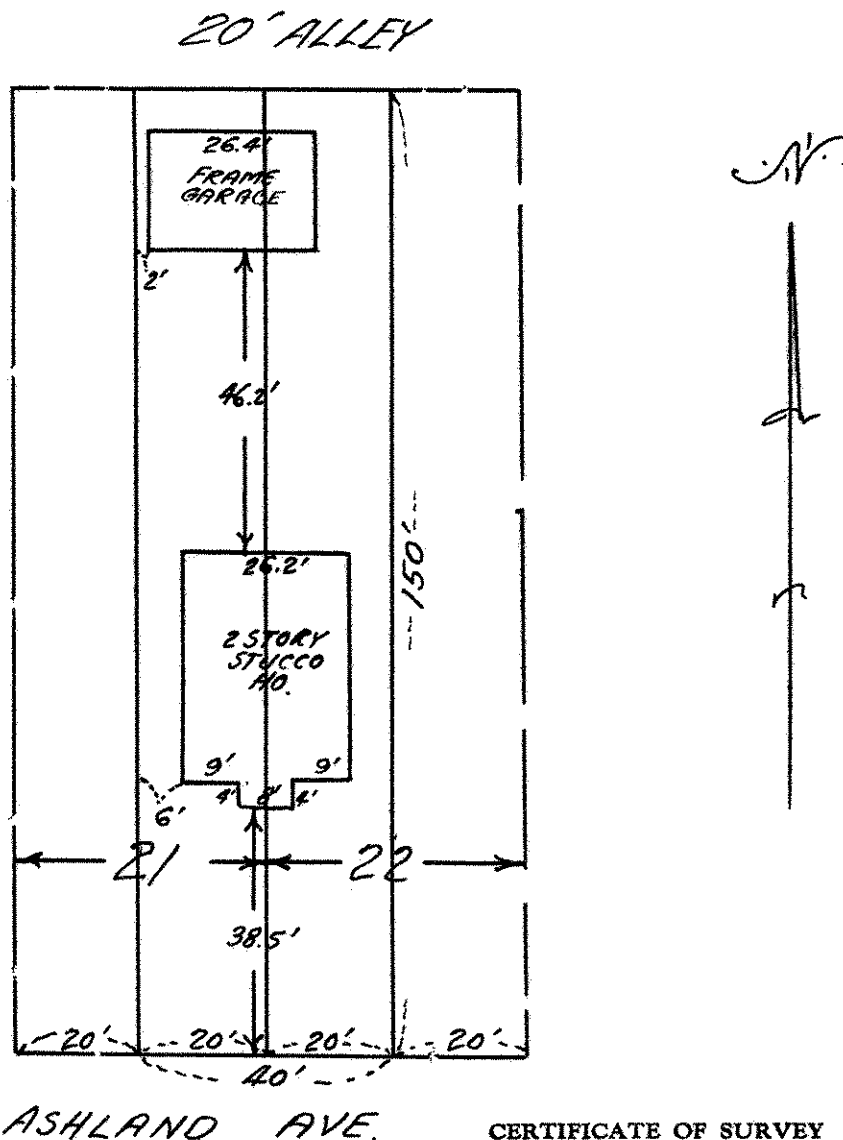

CERTIFICATE OF SURVEY

I hereby certify that on 11-8 19 56

I surveyed the property described above and that the above plat is a correct representation of said survey.

J. J. Welch