

PLAT OF SURVEY


OF PROPERTY OF *Edward K. Delaney*

DESCRIBED AS FOLLOWS *Lot 30, Block 8, Boulevard Addition*

No. 1463 Hague Ave., St. Paul, Minn.

SCALE: 1 INCH 20 FEET

T. J. WELCH, REGISTERED SURVEYOR
738 SURREY AVENUE, ST. PAUL, MINN.

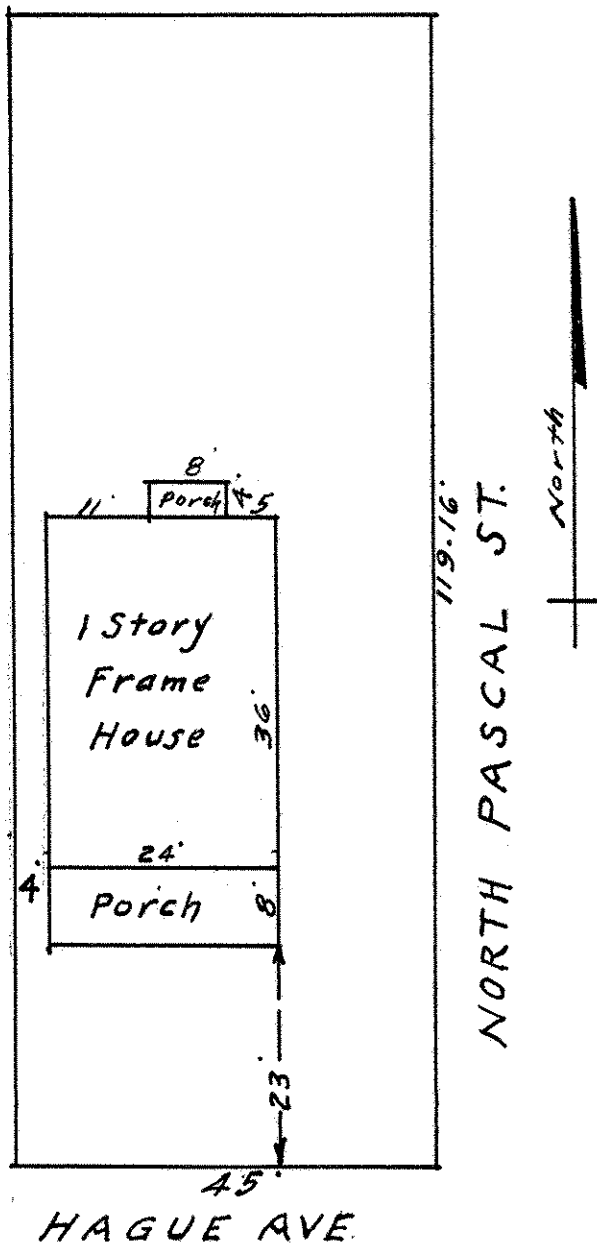

CERTIFICATE OF SURVEY

I hereby certify that on *March 18, 1943*

I surveyed the property described above and that the above plat is a correct representation of said survey.

T. J. Welch