

App. 52496


TELEPHONE 776-0840

PLAT OF SURVEY

OF PROPERTY OF John D. Hoffman and Hyman S. Sigal
DESCRIBED AS FOLLOWS Lot 9, Block 7, Boulevard Addition
Nº 1447 Hague Ave., St. Paul, Minnesota.

SCALE: 1 INCH = 30 FEET

T. J. WELCH, REGISTERED SURVEYOR
701 EAST 3RD STREET, ST. PAUL, MINN. 55106

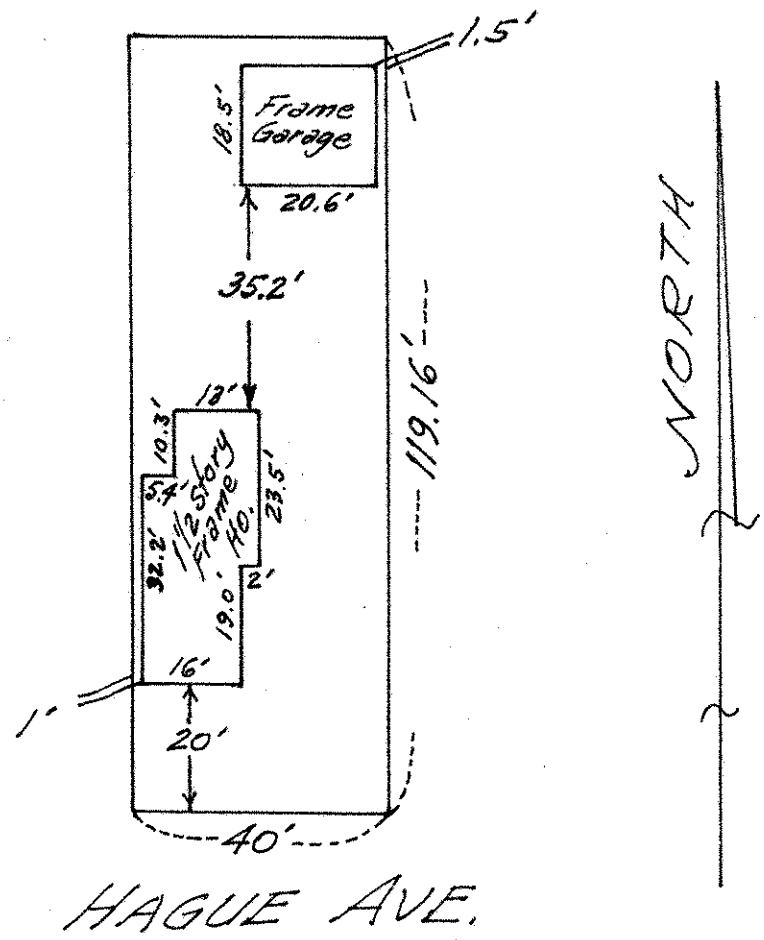

CERTIFICATE OF SURVEY

I hereby certify that on Feb. 20, 1971
I surveyed the property described above and that the above
plat is a correct representation of said survey.

T. J. Welch

This Survey is made exclusively for First Federal
Savings & Loan Assn. of St. Paul.
Lot lines are not guaranteed as this is Survey
for mortgage purposes only.