


OF PROPERTY OF Rodney Davis
DESCRIBED AS FOLLOWS Lot 26 and the West 10 feet of Lot 27 Block 10
Boulevard Addition
No 1417 Laurel Ave. St. Paul, Minn.

T. J. WELCH, REGISTERED SURVEYOR
738 SURREY AVENUE, ST. PAUL 6, MINN.

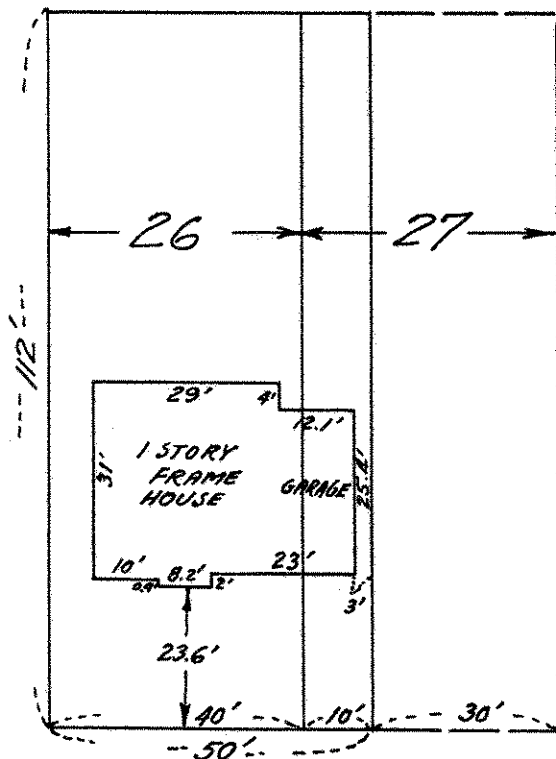

LAUREL AVE.

I hereby certify that on 2-1 19 57

J. J. Walsh