


PLAT OF SURVEY

OF PROPERTY OF *Isabel Mann.*

DESCRIBED AS FOLLOWS *Lot 26, Block 8, of Block E. and D,
Boulevard Add. — No. 1539 Selby Ave. — St. Paul, Minn.*

SCALE: 1 INCH *20* FEET.

T. J. WELCH, REGISTERED SURVEYOR
738 VAN BUREN PLACE, ST. PAUL, MINN.

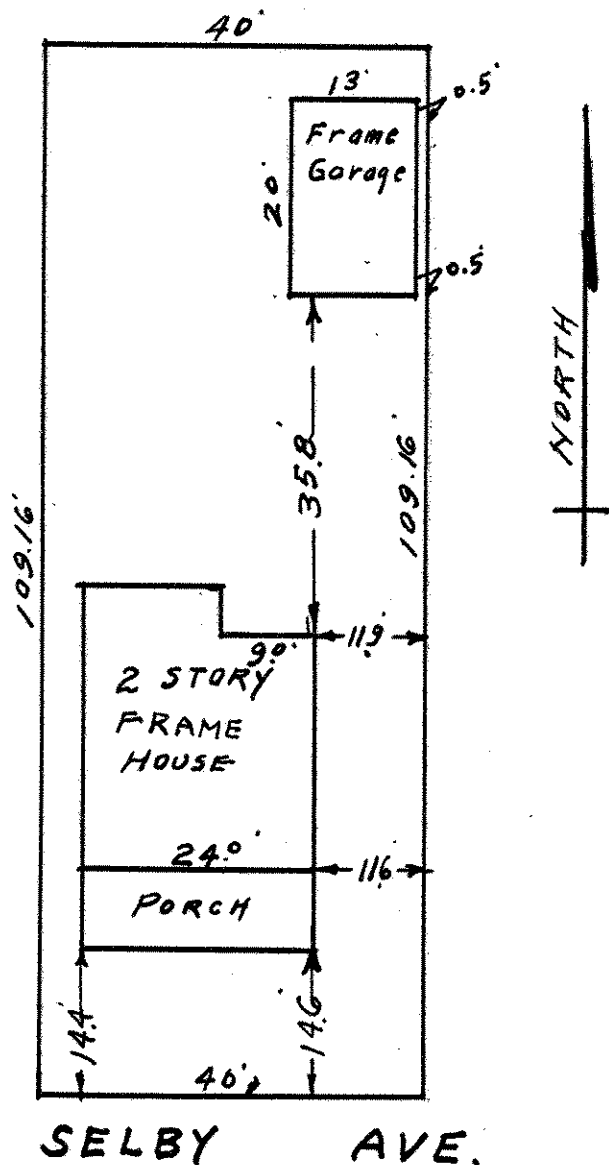

CERTIFICATE OF LOCATION OF BUILDING

I hereby certify that on *May, 20, 1936*
I made a survey of the location of the building on the above
described property and that the location of said building is
correctly shown on the above plat.

T. J. Welch

CERTIFICATE OF SURVEY

I hereby certify that on *May, 20, 1936*
I surveyed the property described above and that the above
plat is a correct representation of said survey.

T. J. Welch