

FROM THE OFFICE OF

CHARLES O. GEORGI COMPANY

2215 West County Road B

Saint Paul, Minnesota 55113

REGISTERED CIVIL ENGINEER AND LAND SURVEYOR

**Certificate
of Survey**

CD District No 8
 Parcel No. 106-F
 Area 6,743 sq. ft. m.o.l.

I Heroby Certify that this plat shows a survey made by me of the property described on this plat, and that the corners are correctly placed as shown, and that all locations have been correctly shown.

Surveyed For Housing Authority


Date July 1977

Scale 1" = 40'

By *Charles O. Georgi*
 REGISTERED LAND SURVEYOR

Description:

The West 40.0 feet of
 Lot 17, Block 2,
 Woodland Park Addition
 Ramsey County, Minnesota.

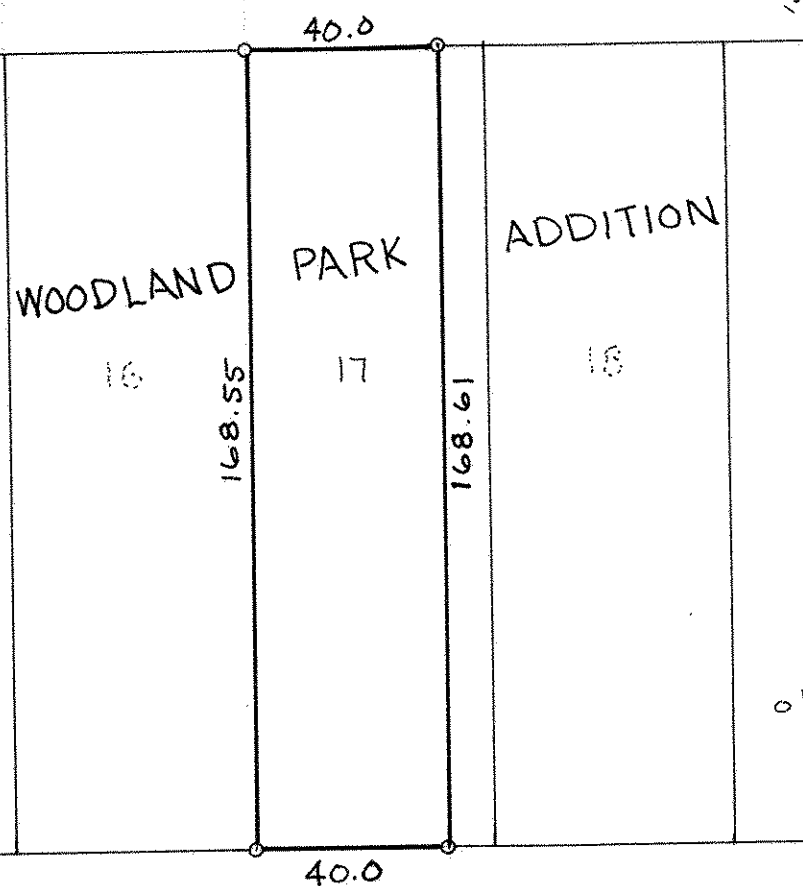

DAYTON AVE.